


T.3S.,R.12E.,WM.

DEPT. OF FISH & WILDLIFE  
WATER PERMITS UNIT  

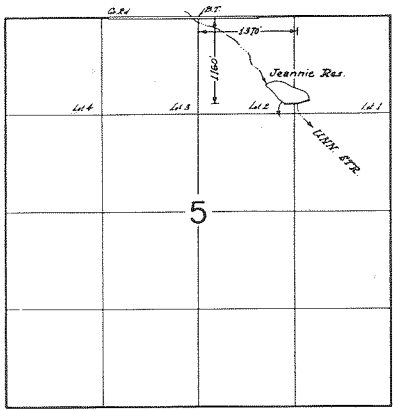

Application No. 61008 E. R-59459  
Permit No. 45436 R 8219

**FINAL PROOF SURVEY**  
UNDER

~~053851~~ ~~06449~~  
~~NO. 09999 Permit No. 11914~~

IN NAME OF  
ORE. DEPT. of FISH & WILDLIFE

Surveyed April 27 1978, by *db Applegate*