


T.20S.,R.5W.,W.M.

Section 1

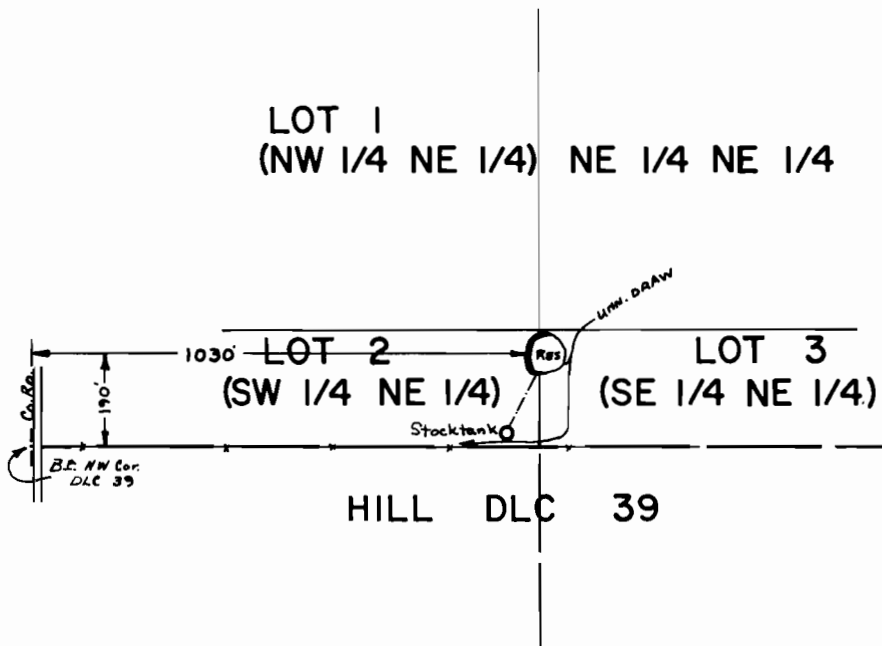

SCALE: 1" = 400'

FINAL PROOF SURVEY

UNDER

Application No. R-60280 Permit No. R-8272
IN NAME OF

ARNE CHRISTOFFERSON

Surveyed July 13, 1982, by L. M. TOLL.....