


T.36S., R.6W., W.M.

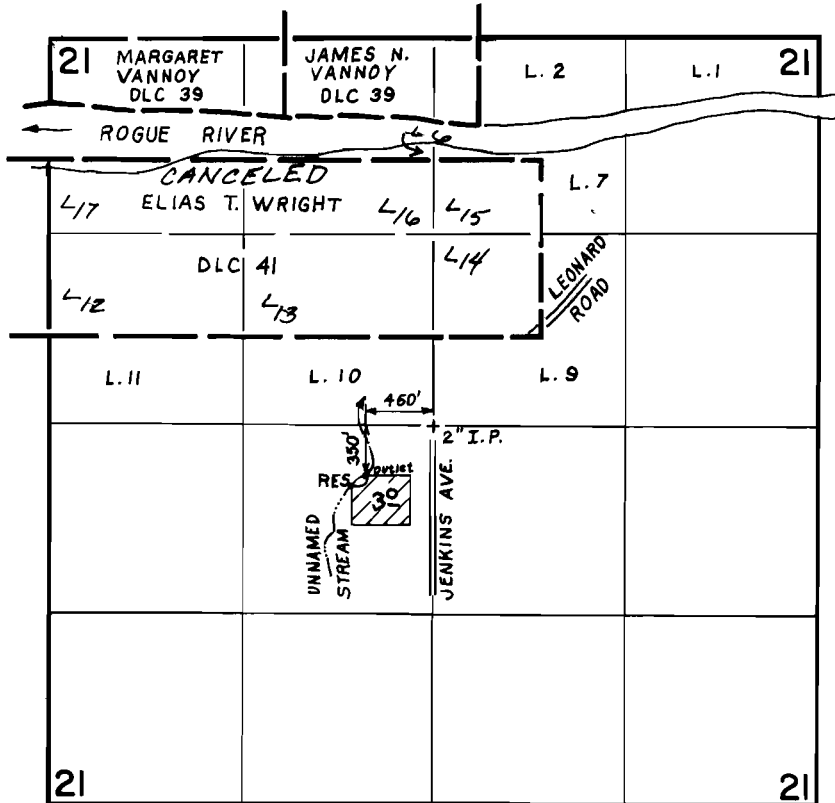

SCALE: 4" = 1 MILE

FINAL PROOF SURVEY UNDER

R-62135 R-8380
 Application No. 62136 Permit No. 46570.....
 IN NAME OF

..... GARY L. HOLM

Surveyed JAN. 18. 19.84, by B. S. JAMES.....