
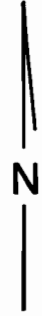


T. 33 S., R. 2 W., W. M.

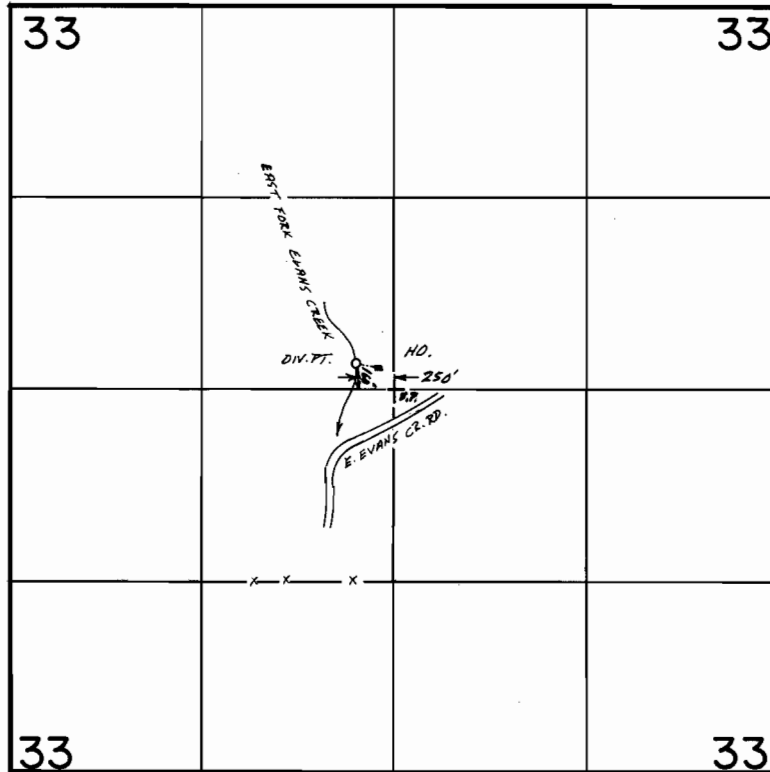

Scale 1"=1320'

FINAL PROOF SURVEY UNDER

Application No. 48027 Permit No. 36017.....
IN NAME OF

.....JAMES P. CUEAUDE.....

Surveyed July 10, 1986, by B.S. JAMES.....