


T. 41 S., R. 1 E., W. M.

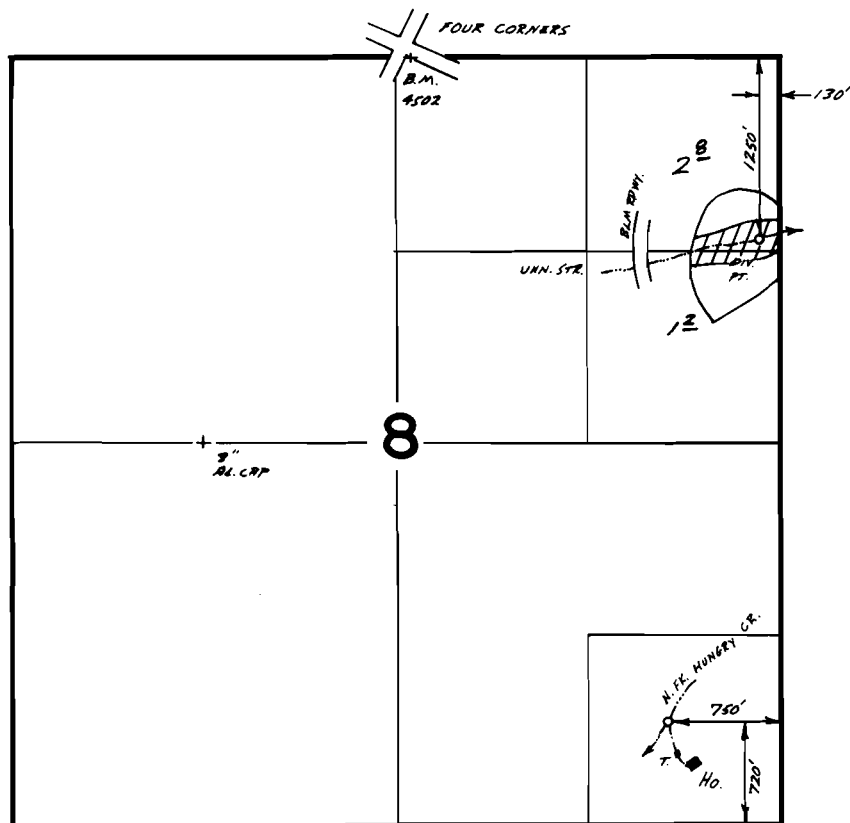

Scale 1" = 1320'

FINAL PROOF SURVEY UNDER

Application No. 52214.... Permit No. 39310.....
IN NAME OF

.....EDWIN B. CASWELL.....

Surveyed Aug. 7,.... 1986, by B.S. JAMES.....