90684

T. 6N., R. 38E., W.M.

SECTION 18

SCALE 1" = 400'

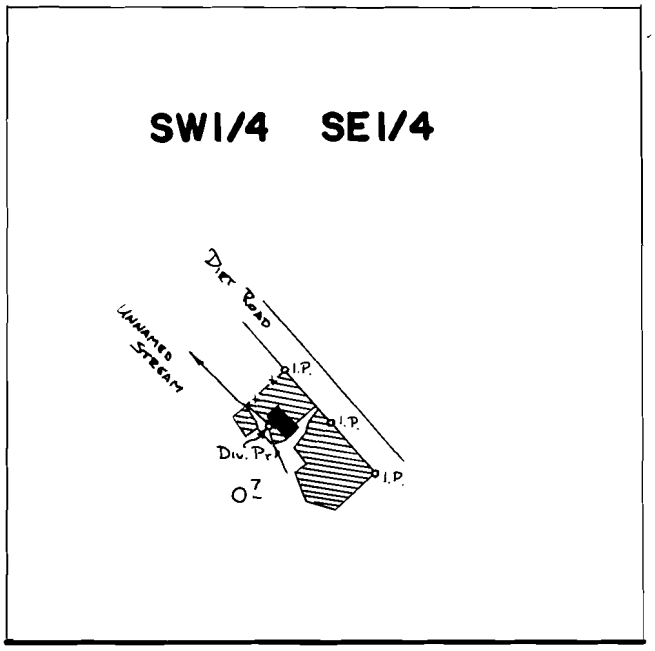

DIV. PT. LOC: 450'N. & 540'E FROM S1/4 COR. SEC. 18

FINAL PROOF SURVEY
UNDER

Application No. 53379 Permit No. 39733
IN NAME OF

BERNICE E. GILCHER

Surveyed 4-28 1987, by V.L. Church

PTS-1987-PC JLC