


T. 3 S. R. 10 W. W.M.

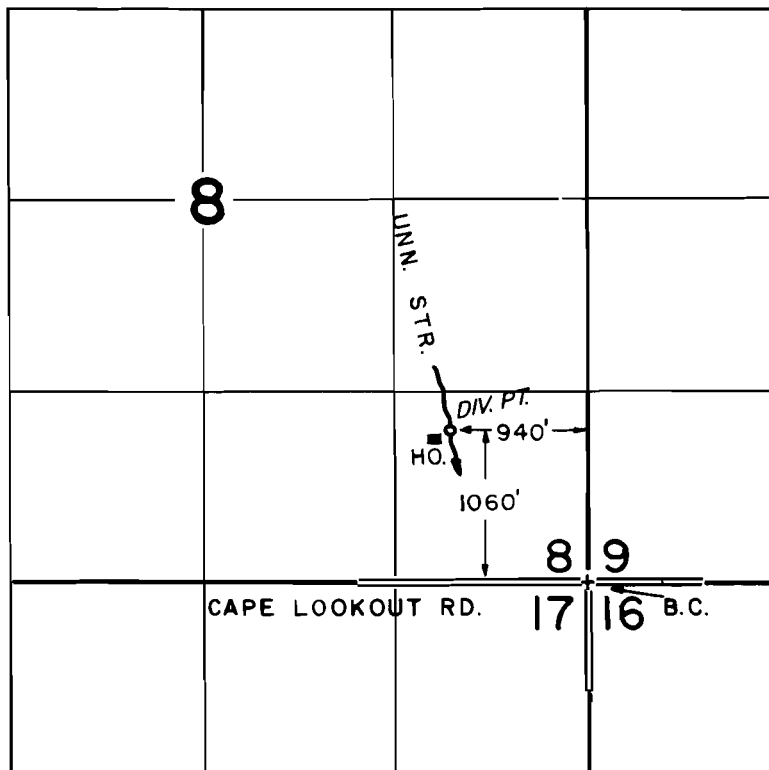

FINAL PROOF SURVEY
UNDER

Application No. 54838 Permit No. 41137.....
IN NAME OF

THOMAS LORN EDWARDS

Surveyed O.C.T. 27. 1983, by P. Proctor.....