
90684

T.5S., R.6&7W., W. M.

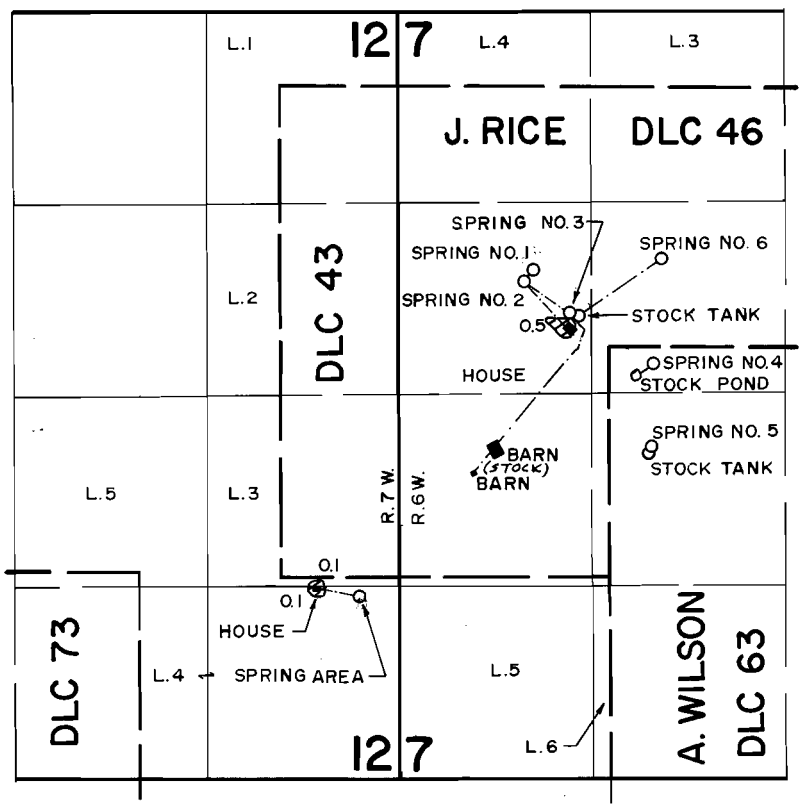

SPRING LOCATION: NO.1-1250'S. & 930'E.; NO.2-1340'S. & 860'E; NO.3-1550'S. & 1180'E; NO.4-1900'S. & 1750'E.; NO.5-2460'S. & 1740'E.; NO.6-1180'S. & 1810E.; SPRING AREA-3510'S. & 280'W.; ALL FROM THE S.W. CORNER OF LOT 4 (SECTION 7).

N

FINAL PROOF SURVEY
UNDER

SCALE: 4" = 1 MILE

Application No. 55249 Permit No. 41549
IN NAME OF

JOSEPHINE R. MENDENHALL

Surveyed NOV. 5, 1984, by P. Pagter

DFQ-3LL-43 PRP 3/8/85