


P 42346

58108

Application No. 56402
Permit No. 42346

T.39S. R.20E. W.M.

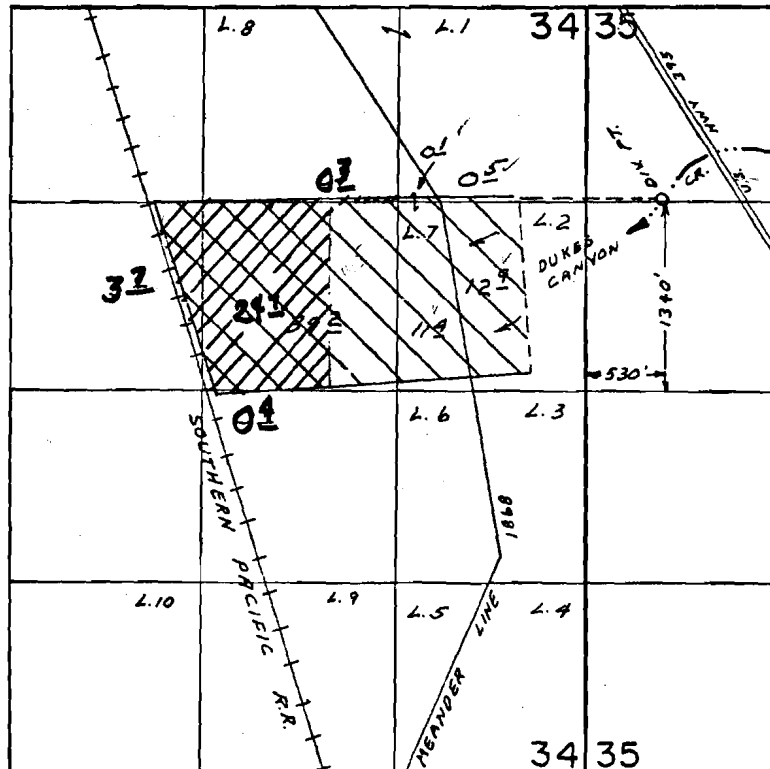

FINAL PROOF SURVEY
UNDER

Application No. ~~47862~~ Permit No. ~~35869~~
IN NAME OF

JOHN W. RICHARDSON

Surveyed JUL 9 1975, by LH NUNN

RECEIVED

APR 11 1977

WATER RESOURCES DEPT.
SALEM, OREGON