


43332
58109

T. 40 S., R. 22 E., W. M.

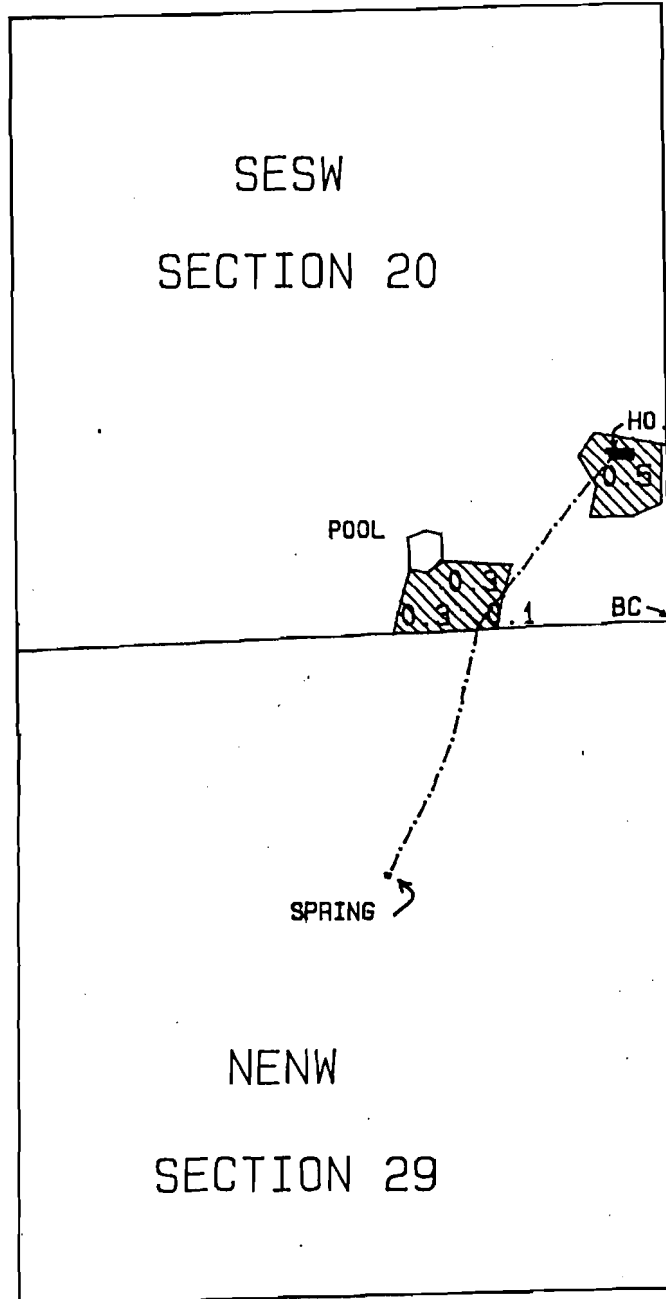

SCALE: 1" = 400'

SPRING LOCATED 520 FT. S. AND 590 FT. W. FROM S.1/4 COR. SEC. 20

FINAL PROOF SURVEY

UNDER

APPLICATION NO. 57513 PERMIT NO. 43332

APPLICATION NO. 66012 PERMIT NO. 48043

IN NAME OF

DONALD JOSEPH & ZELMA A. CALLAGHAN

Surveyed Oct. 18, 1987 By V.L. CHURCH

Photo: PTS JCL