


T. 17 S., R. 6 W. W.M.

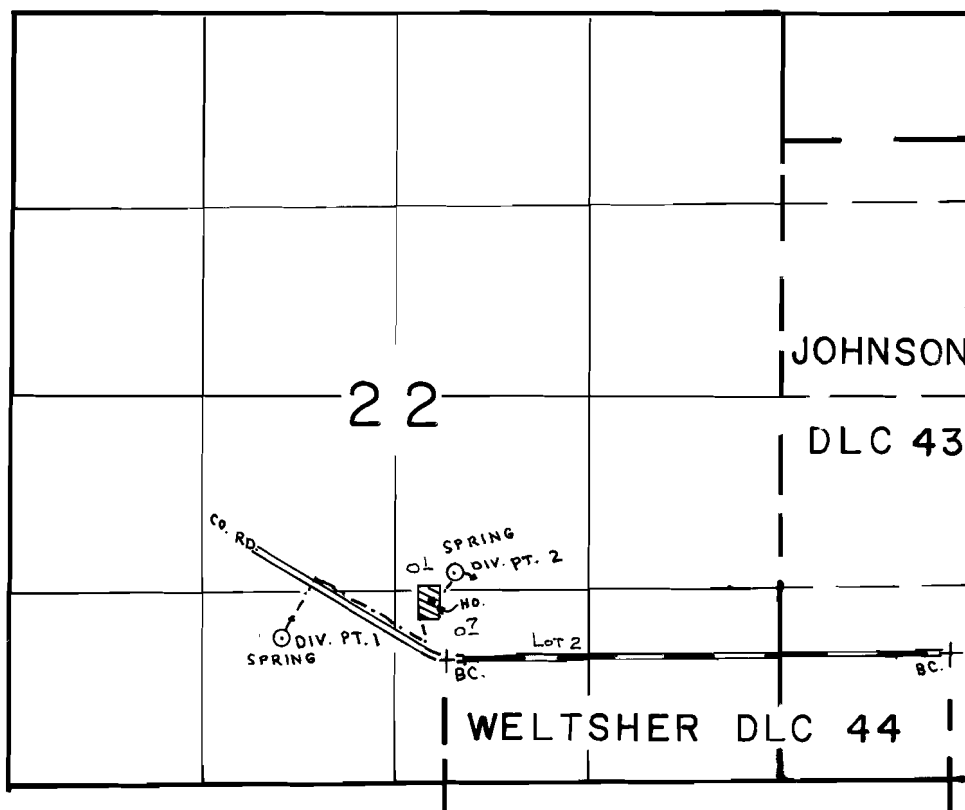

DIV. PT. LOC.: * 1, 160' N & 1130' W. OF NW COR. DLC 44
2, 600' N. & 40' E. OF NW COR. DLC 44

FINAL PROOF SURVEY UNDER

Application No. 57671 Permit No. 43392

IN NAME OF

JOHN W. WELTON III

Surveyed NOV. 17 1983, by PAGTER, P