
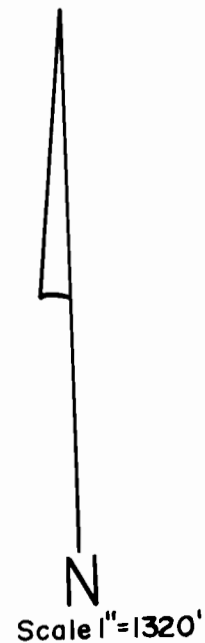


T. 5 S., R. 17 & 18 E., W.M.

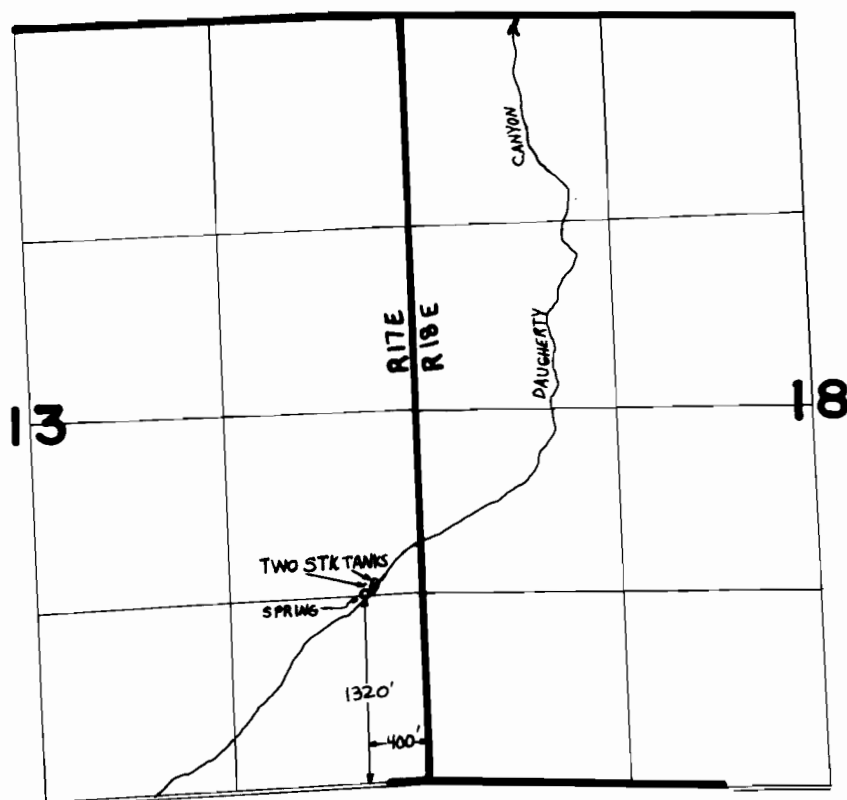

FINAL PROOF SURVEY
UNDER

Application No. 58184.. Permit No. 43773.....
IN NAME OF

.....**ORVILLE D. THOMPSON**.....

Surveyed May 14... 1986, by V. Church.....