


T.13S.,R.1E.,W.M.

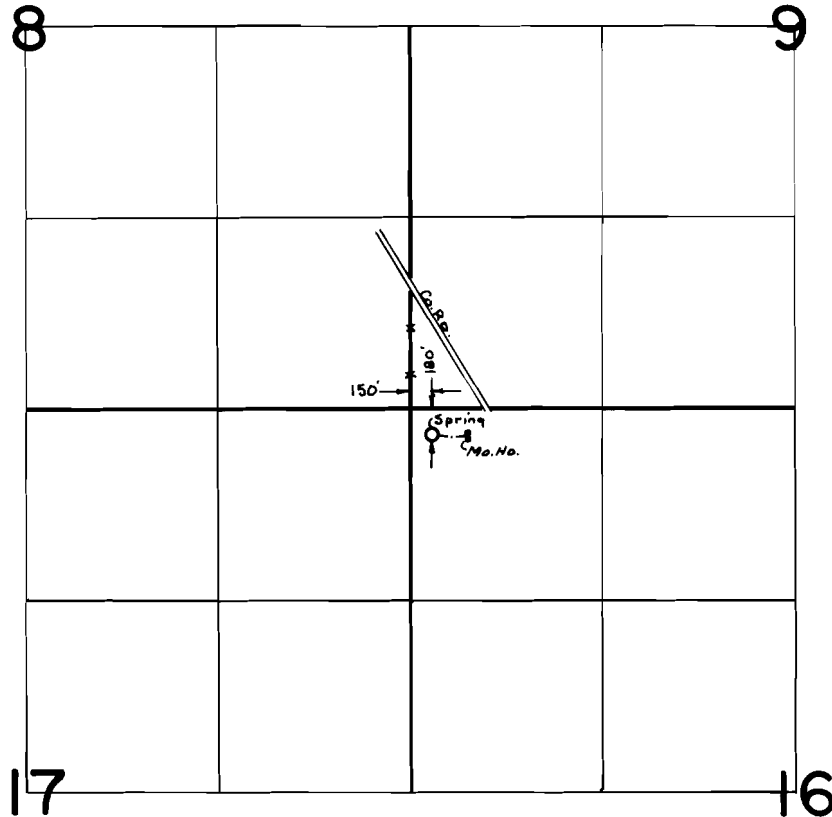

FINAL PROOF SURVEY
UNDER

Application No. ..58461... Permit No.44035....

IN NAME OF

STEVEN LOREN &

.....LINDA SUE BROWN.....

Surveyed April 26, 1982., by L.M.TOLL.....