


45654
58115

T. 39 S., R. 19 E., W. M.

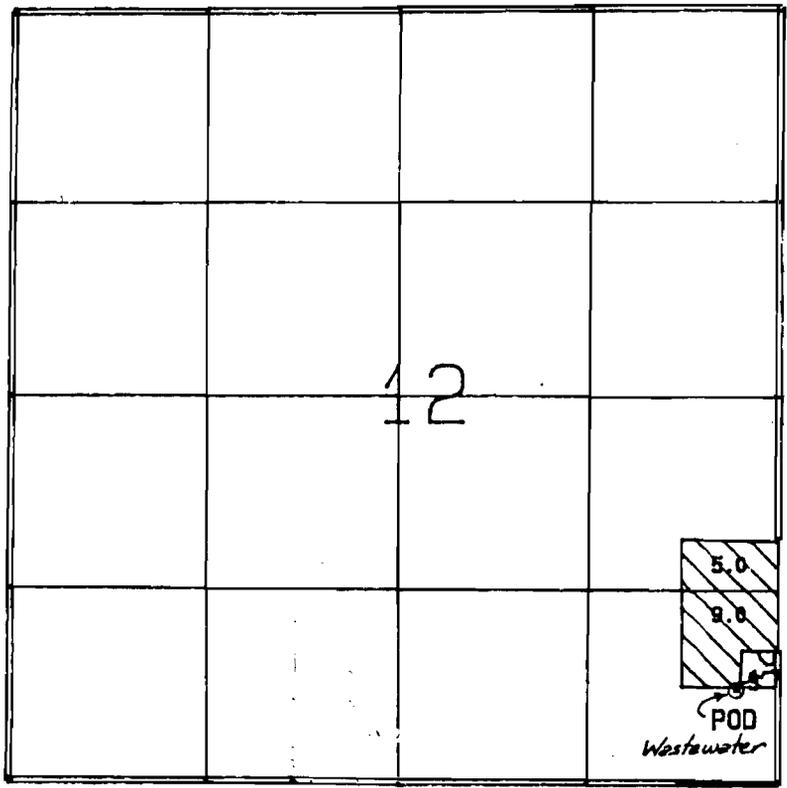

POD LOCATED 660 FT. N. AND 290 FT. W. FROM SE COR. SEC. 12

SCALE: 1 = 1320

FINAL PROOF SURVEY

UNDER

Application No. 61350 Permit No. 45654

IN NAME OF

WINSOME WELLS

Surveyed Oct. 16, 1987 By M. J. MATTICK

Photo: 379-89A LN