


T. 13 S., R. 9 E., W.M.

SECTION 10

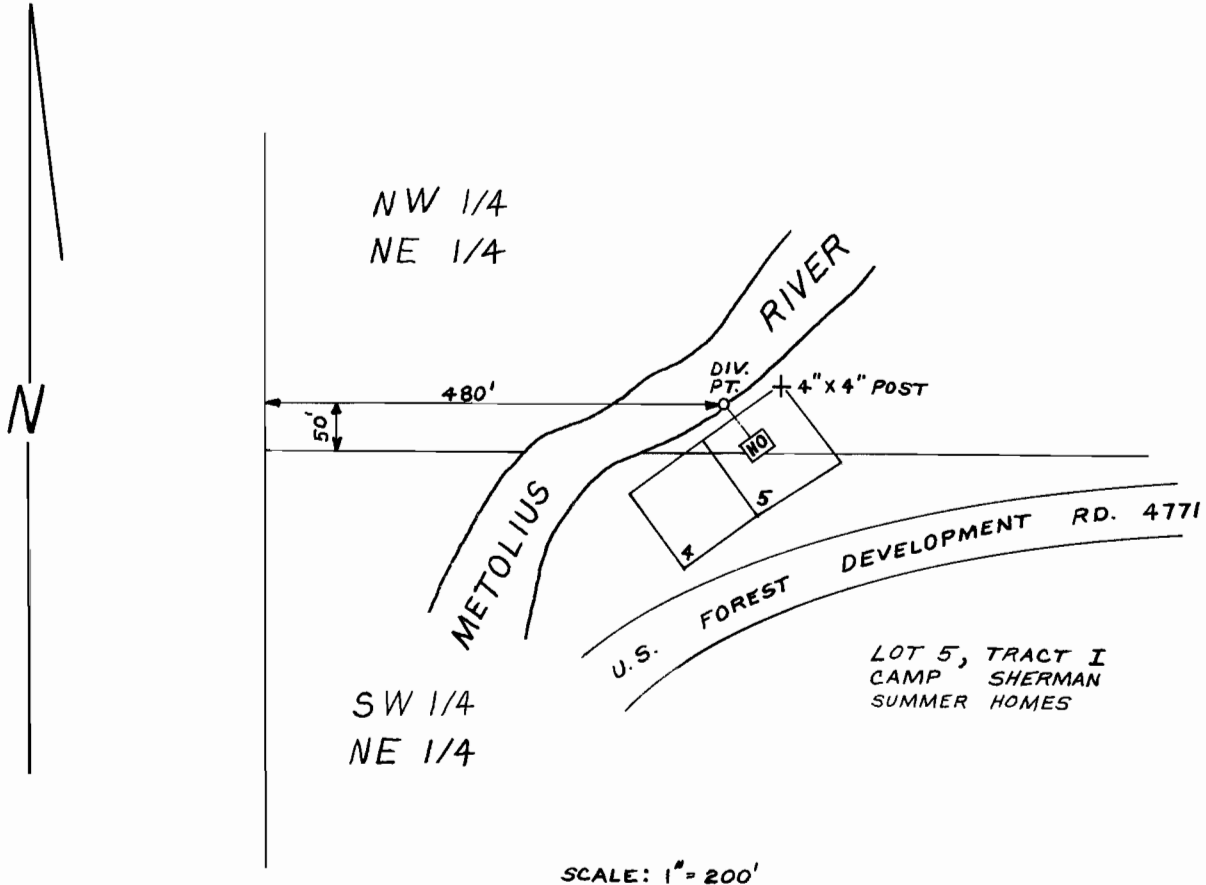

FINAL PROOF SURVEY

UNDER

Application No. 63457..Permit No. 46989.....

IN NAME OF

WILLIAM E. & DELORES ANDYKE

Surveyed MAY 1, 19 85, by LESLIE OLSON.