


T. 13 S., R. 9 E., W.M.

SECTION 10

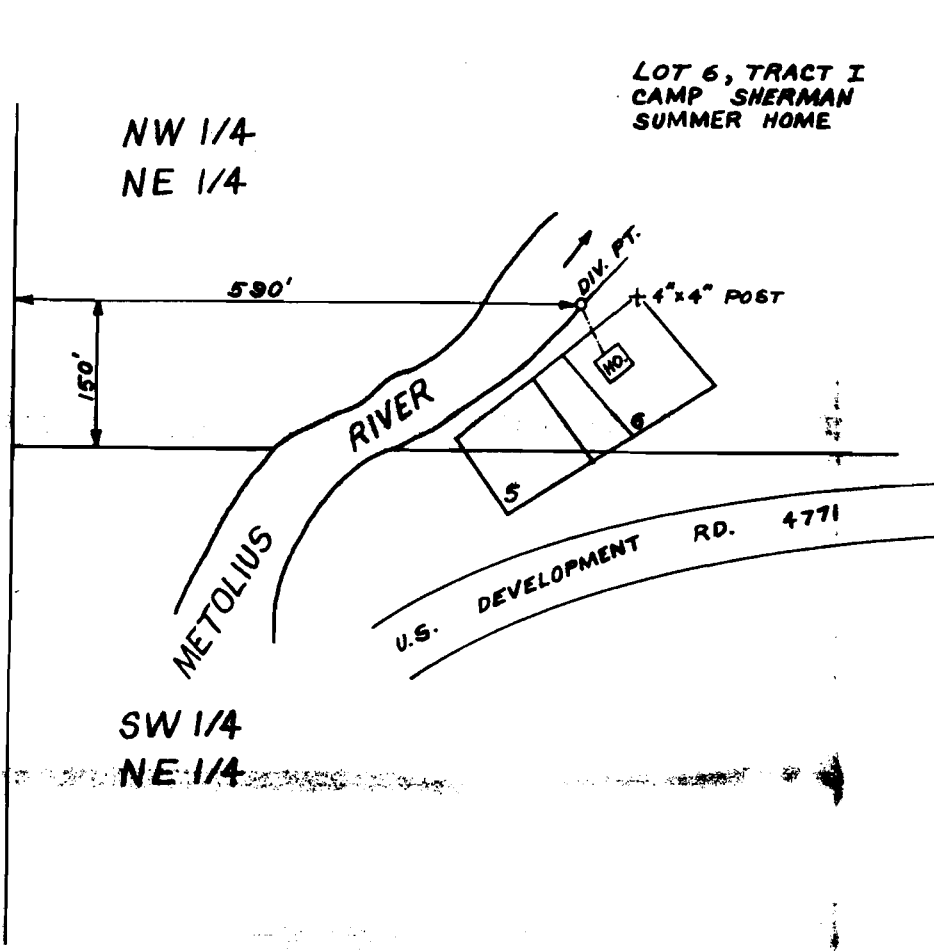

LOT 6, TRACT I
CAMP SHERMAN
SUMMER HOME

SCALE: 1" = 200'

FINAL PROOF SURVEY
UNDER

Application No. 63482 Permit No. 47150

cert. 58117
Dom incl. 0²⁵

IN NAME OF

HAROLD OLSON

HAROLD E. RICE

Surveyed MAY 1 19 85, by LESLIE OLSON