


T. 13 S., R. 9 E., W.M.

SECTION 10

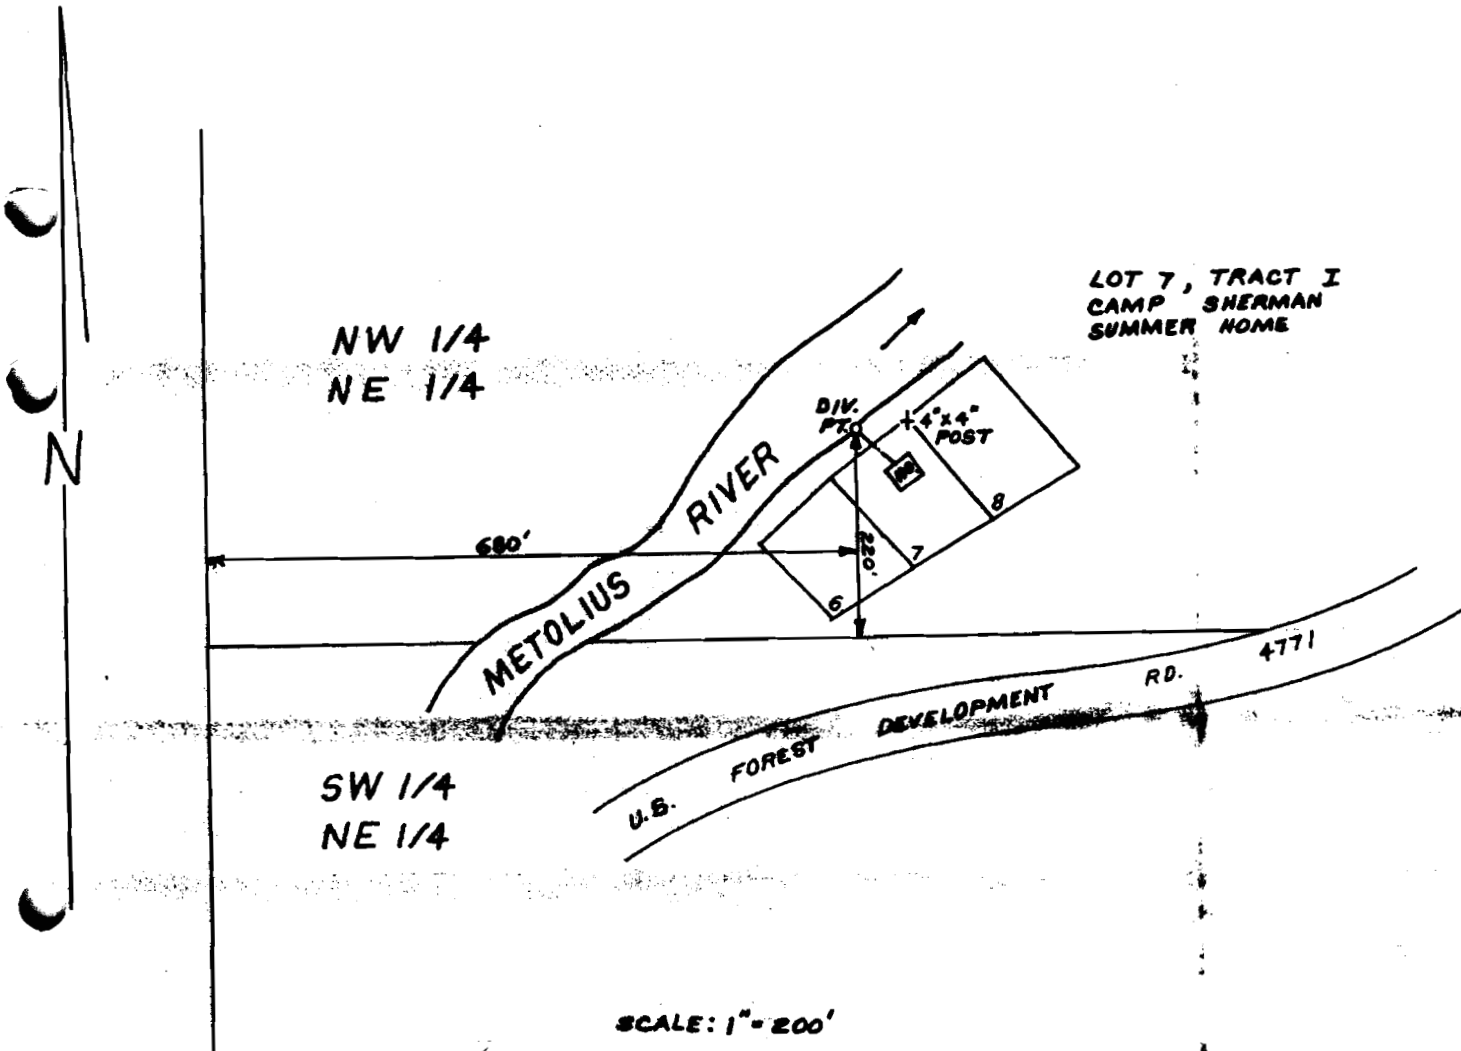

FINAL PROOF SURVEY

UNDER

Application No. 68709 Permit No. 47210

IN NAME OF

ROBERT L. BOLDT

Surveyed MAY 1 19 85, by LESLIE OLSON

cert. 58118
Dom