


T. 13 S., R. 9 E., W.M.
SECTION 10

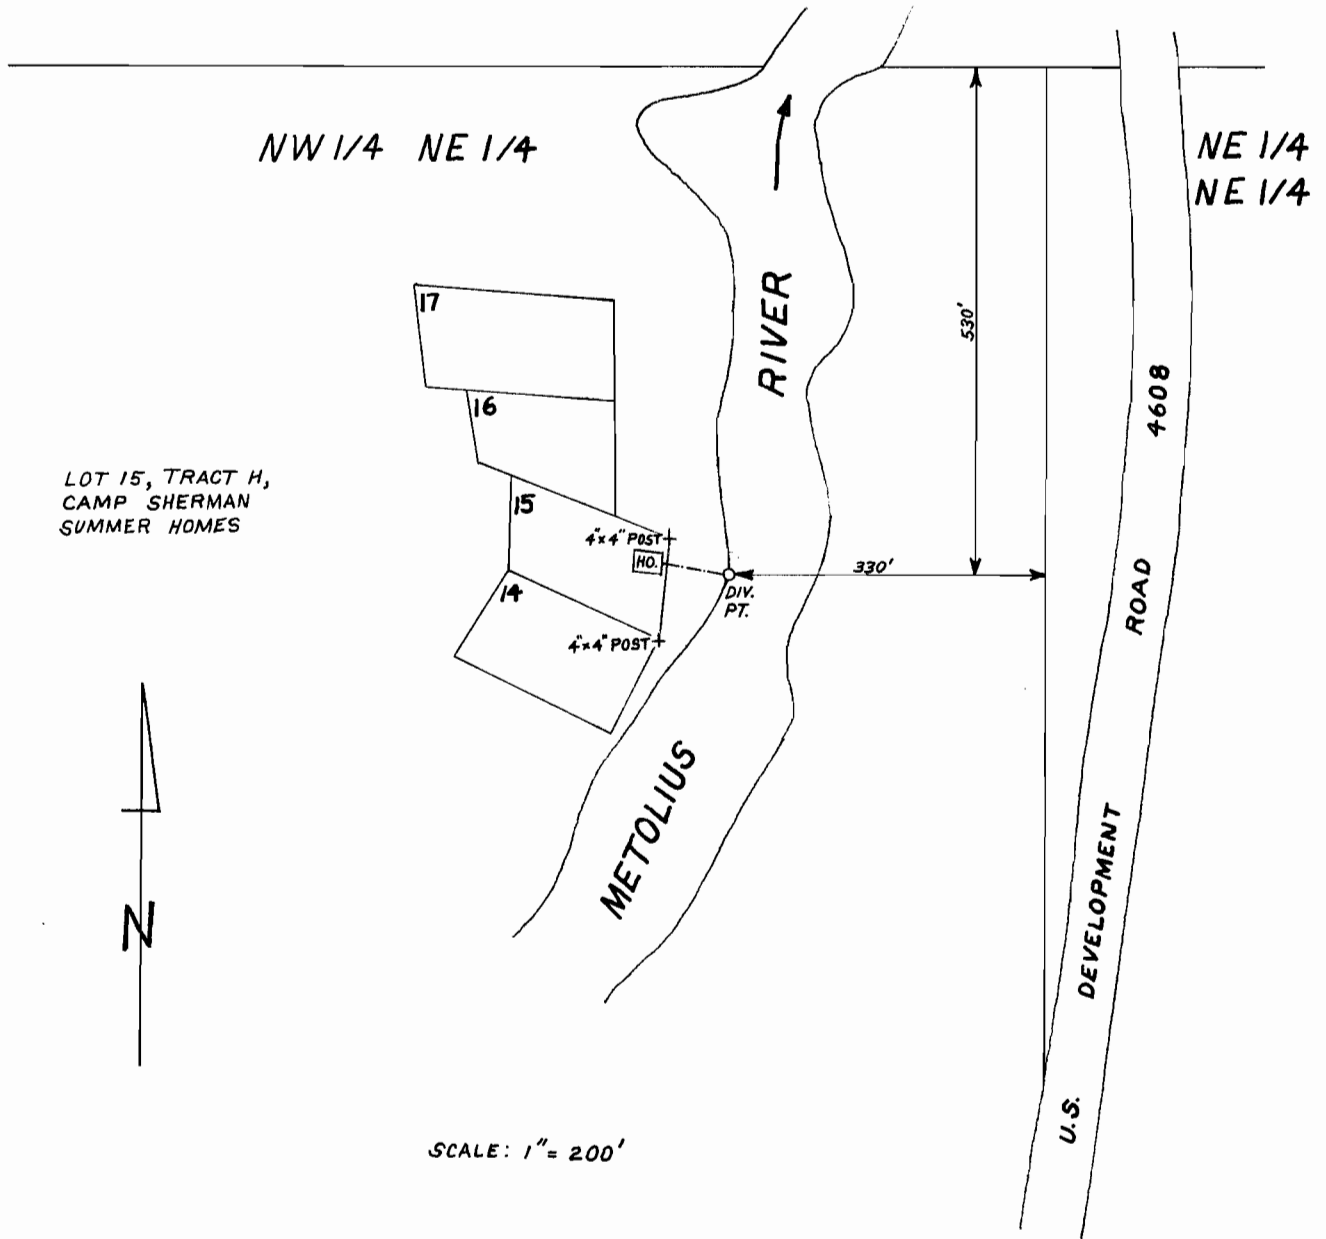

FINAL PROOF SURVEY

UNDER

Application No. 64567 Permit No. 47332

IN NAME OF

GLEN R. & JUNE S. LAYTON

Surveyed FEB. 28 19 85, by LESLIE OLSON