


T. 13 S., R. 9 E., W.M.

SECTION 10

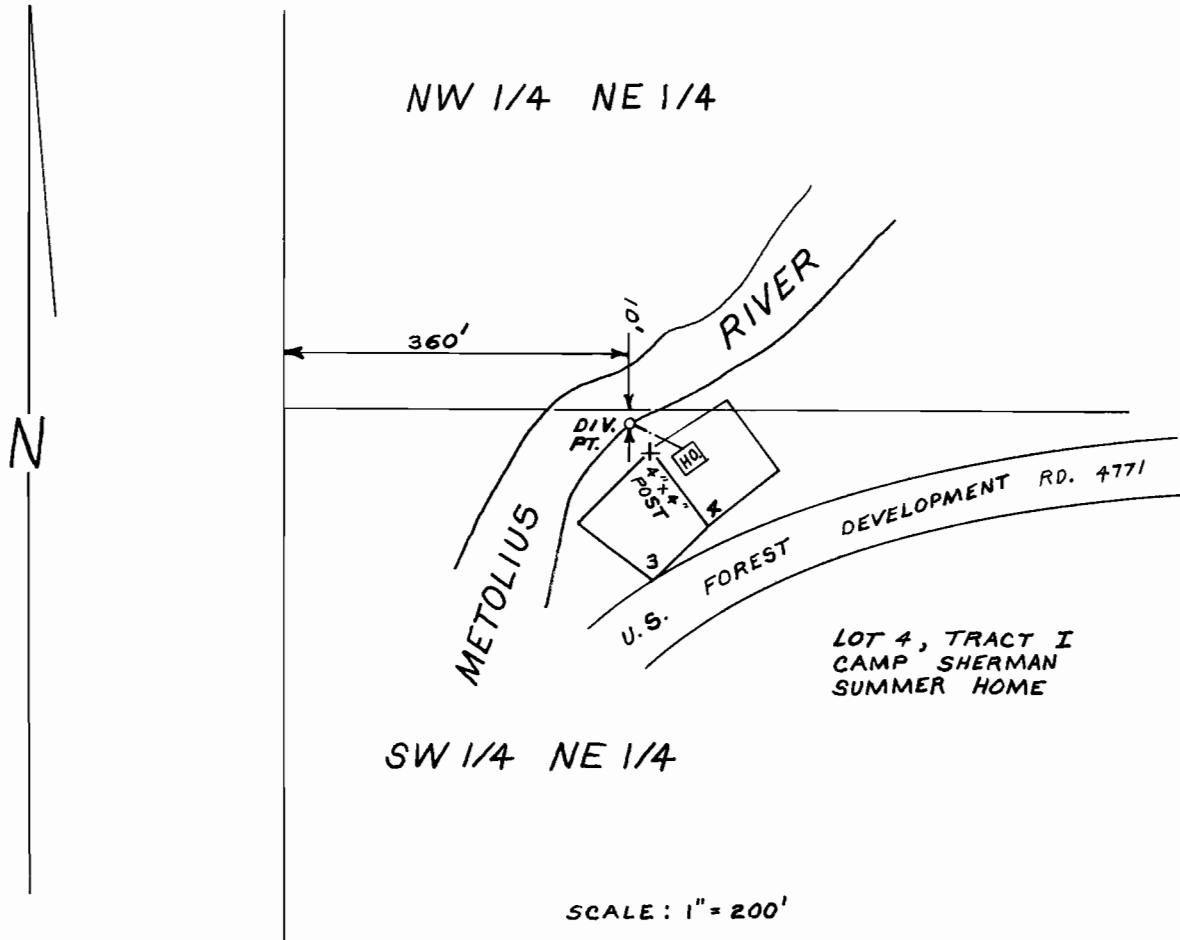

FINAL PROOF SURVEY

UNDER

Application No. 65348. Permit No. 47942

IN NAME OF

ERNEST V. LEWIS

Surveyed MAY 1 1985, by LESLIE OLSON