

UNITED STATES
DEPARTMENT OF THE INTERIOR
BUREAU OF LAND MANAGEMENT

OPALITE

SECTION 28


Oregon State Water Filings

NW $\frac{1}{4}$ NE $\frac{1}{4}$

TOWNSHIP 40S, RANGE 40E, W. M.

SCALE 8" = 1 MI.

North

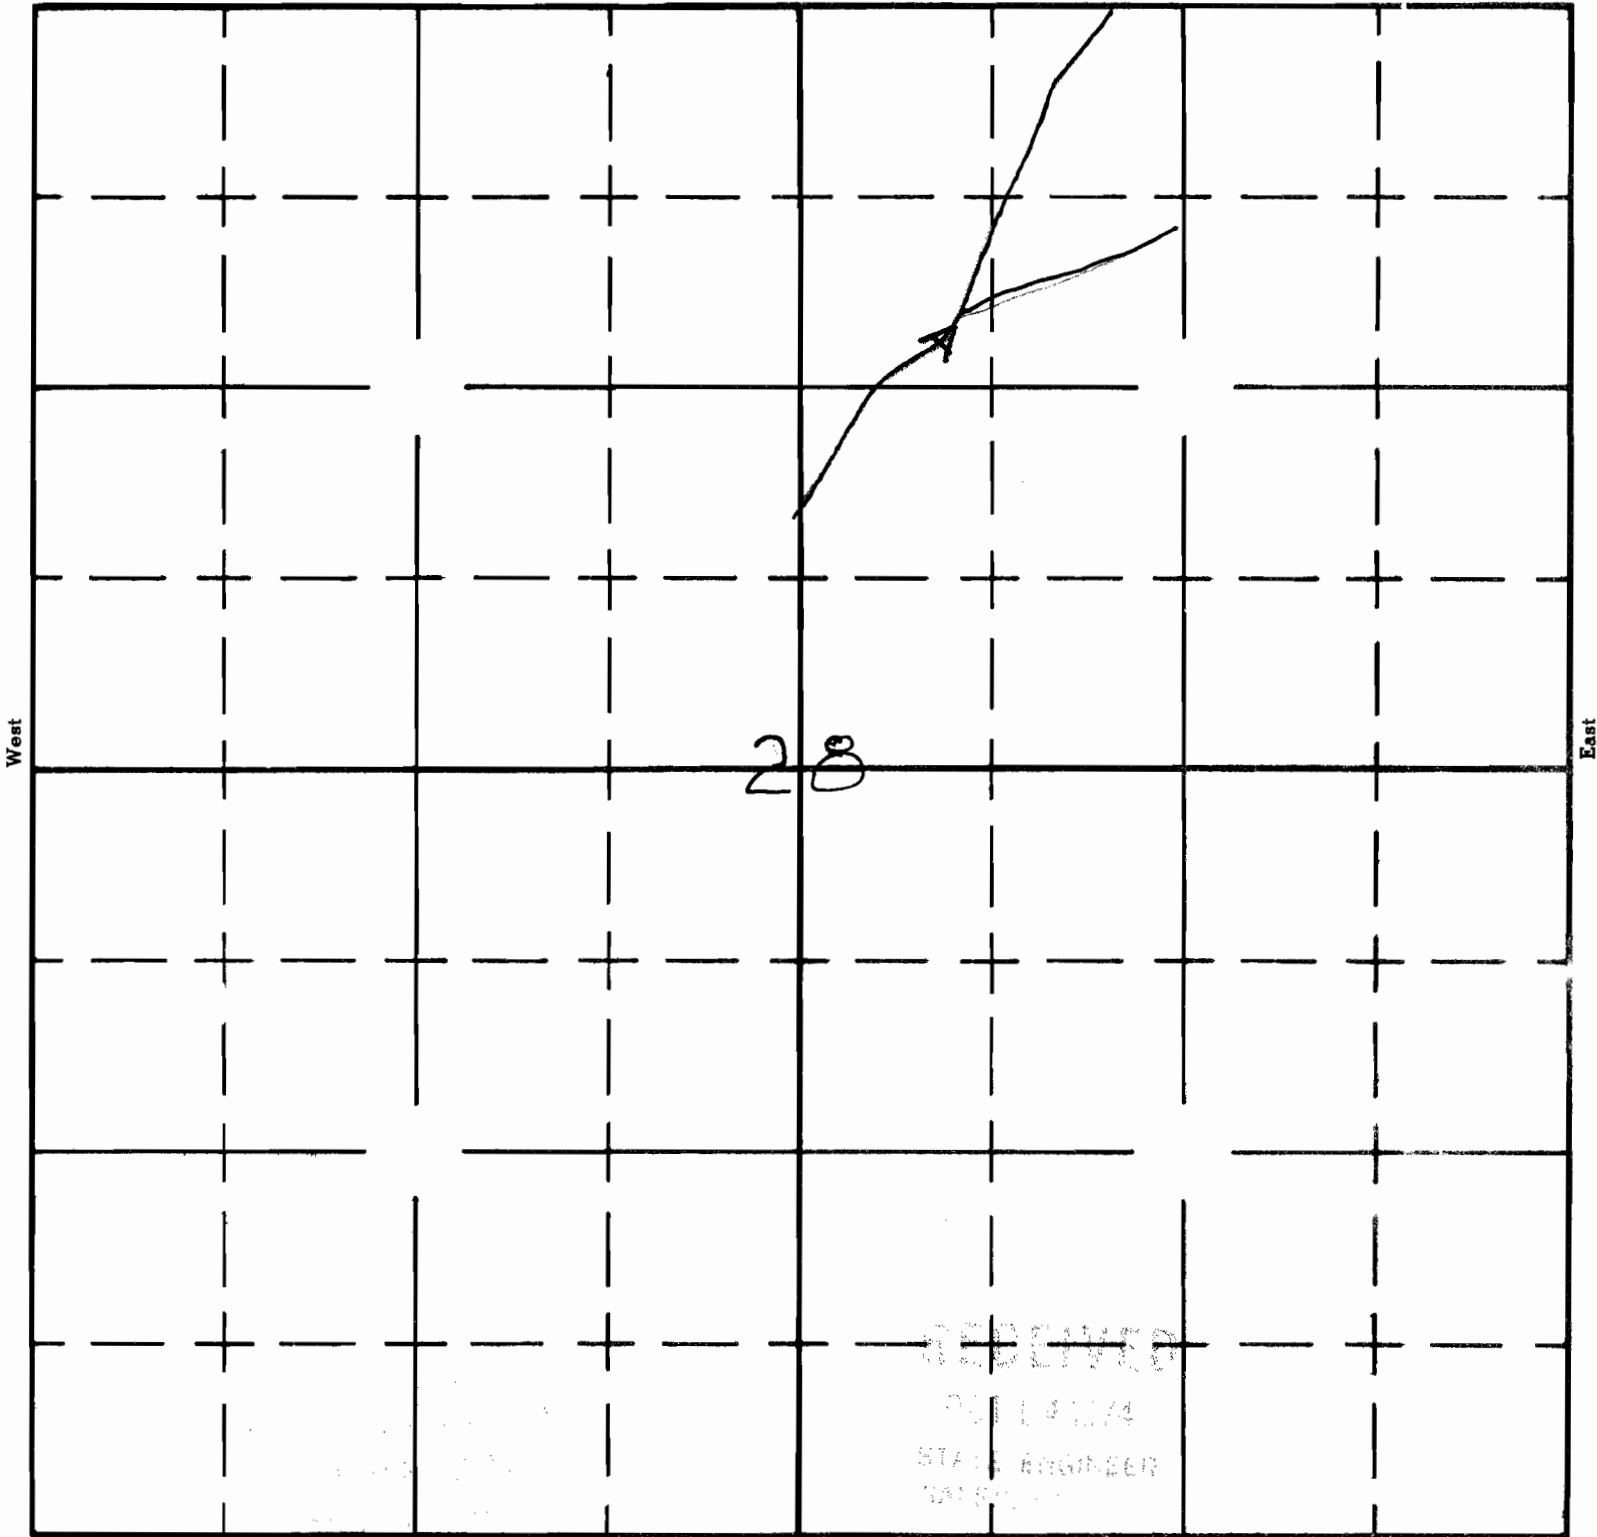

South

RECEIVED
JUL 14 1974
STATE ENGINEER
SALES

APPLICATION No. R-52293
PERMIT No. 7508