

Form AI-187  
March 1961

UNITED STATES  
DEPARTMENT OF THE INTERIOR  
BUREAU OF LAND MANAGEMENT


SECTION

1 Oregon State Water Filings

TOWNSHIP 26S, RANGE 41E, W. M.

S. E. RESERVOIR  
North

RECEIVED  
BUREAU OF LAND MANAGEMENT  
WASHINGTON, D. C.

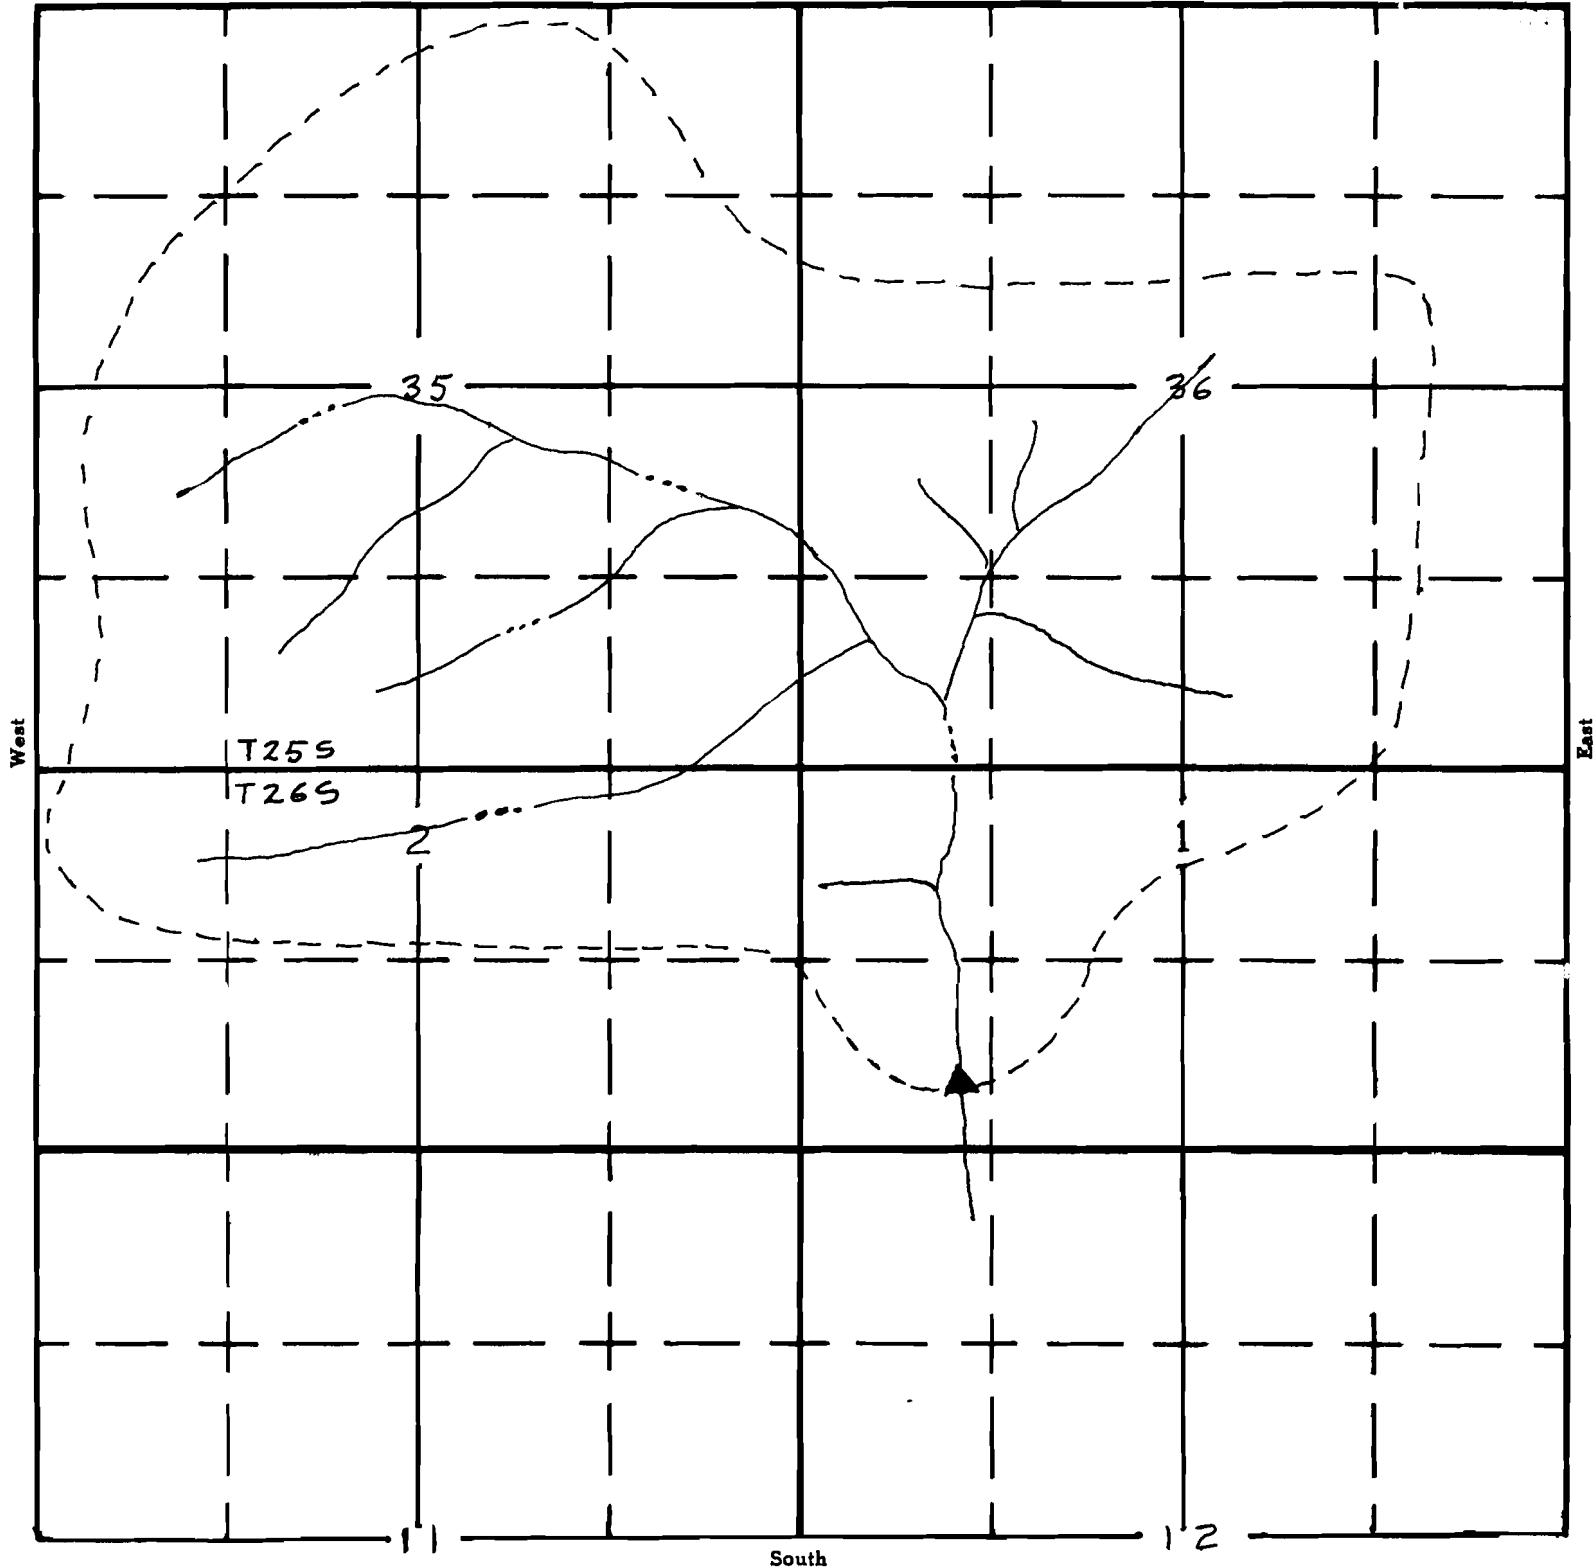

APPLICATION No. A-40682  
PERMIT No. 7878