


UNITED STATES
DEPARTMENT OF THE INTERIOR
BUREAU OF LAND MANAGEMENT

SECTION
SE¹ NW⁴
Sec. 13

Oregon State Water Filings

TOWNSHIP 23S, RANGE 42E, W. M.

North

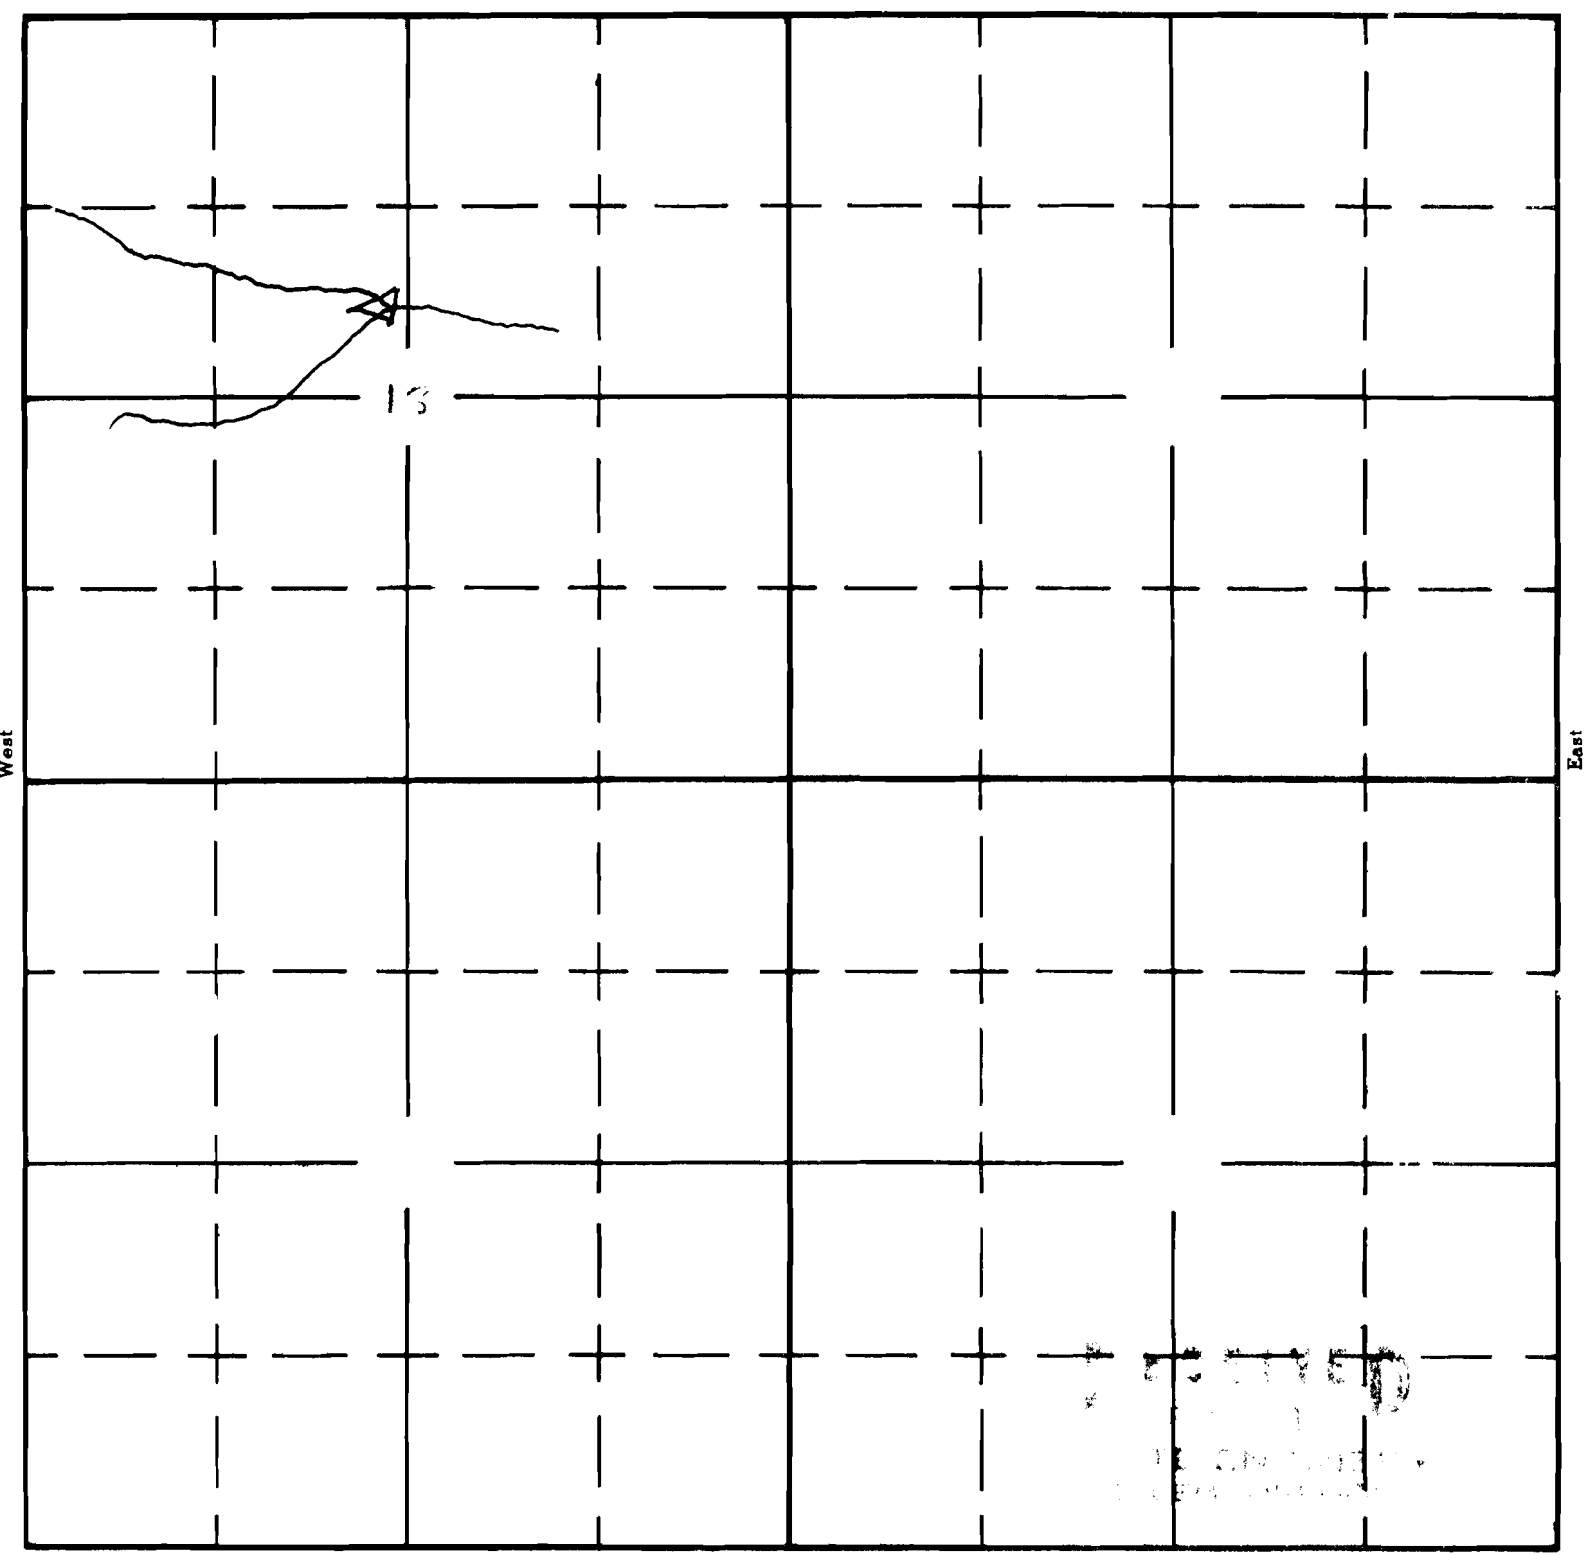

South

SOUTH SHEEP CREEK RCD

APPLICATION No. 15807
PERMIT No. 15807