

UNITED STATES
DEPARTMENT OF THE INTERIOR
BUREAU OF LAND MANAGEMENT

SECTION 25
SW $\frac{1}{4}$ SE $\frac{1}{4}$


Oregon State Water Filings

PEDRO

TOWNSHIP 19 S, RANGE 38 E, W. M.

SCALE 8" = 1 MI.

North

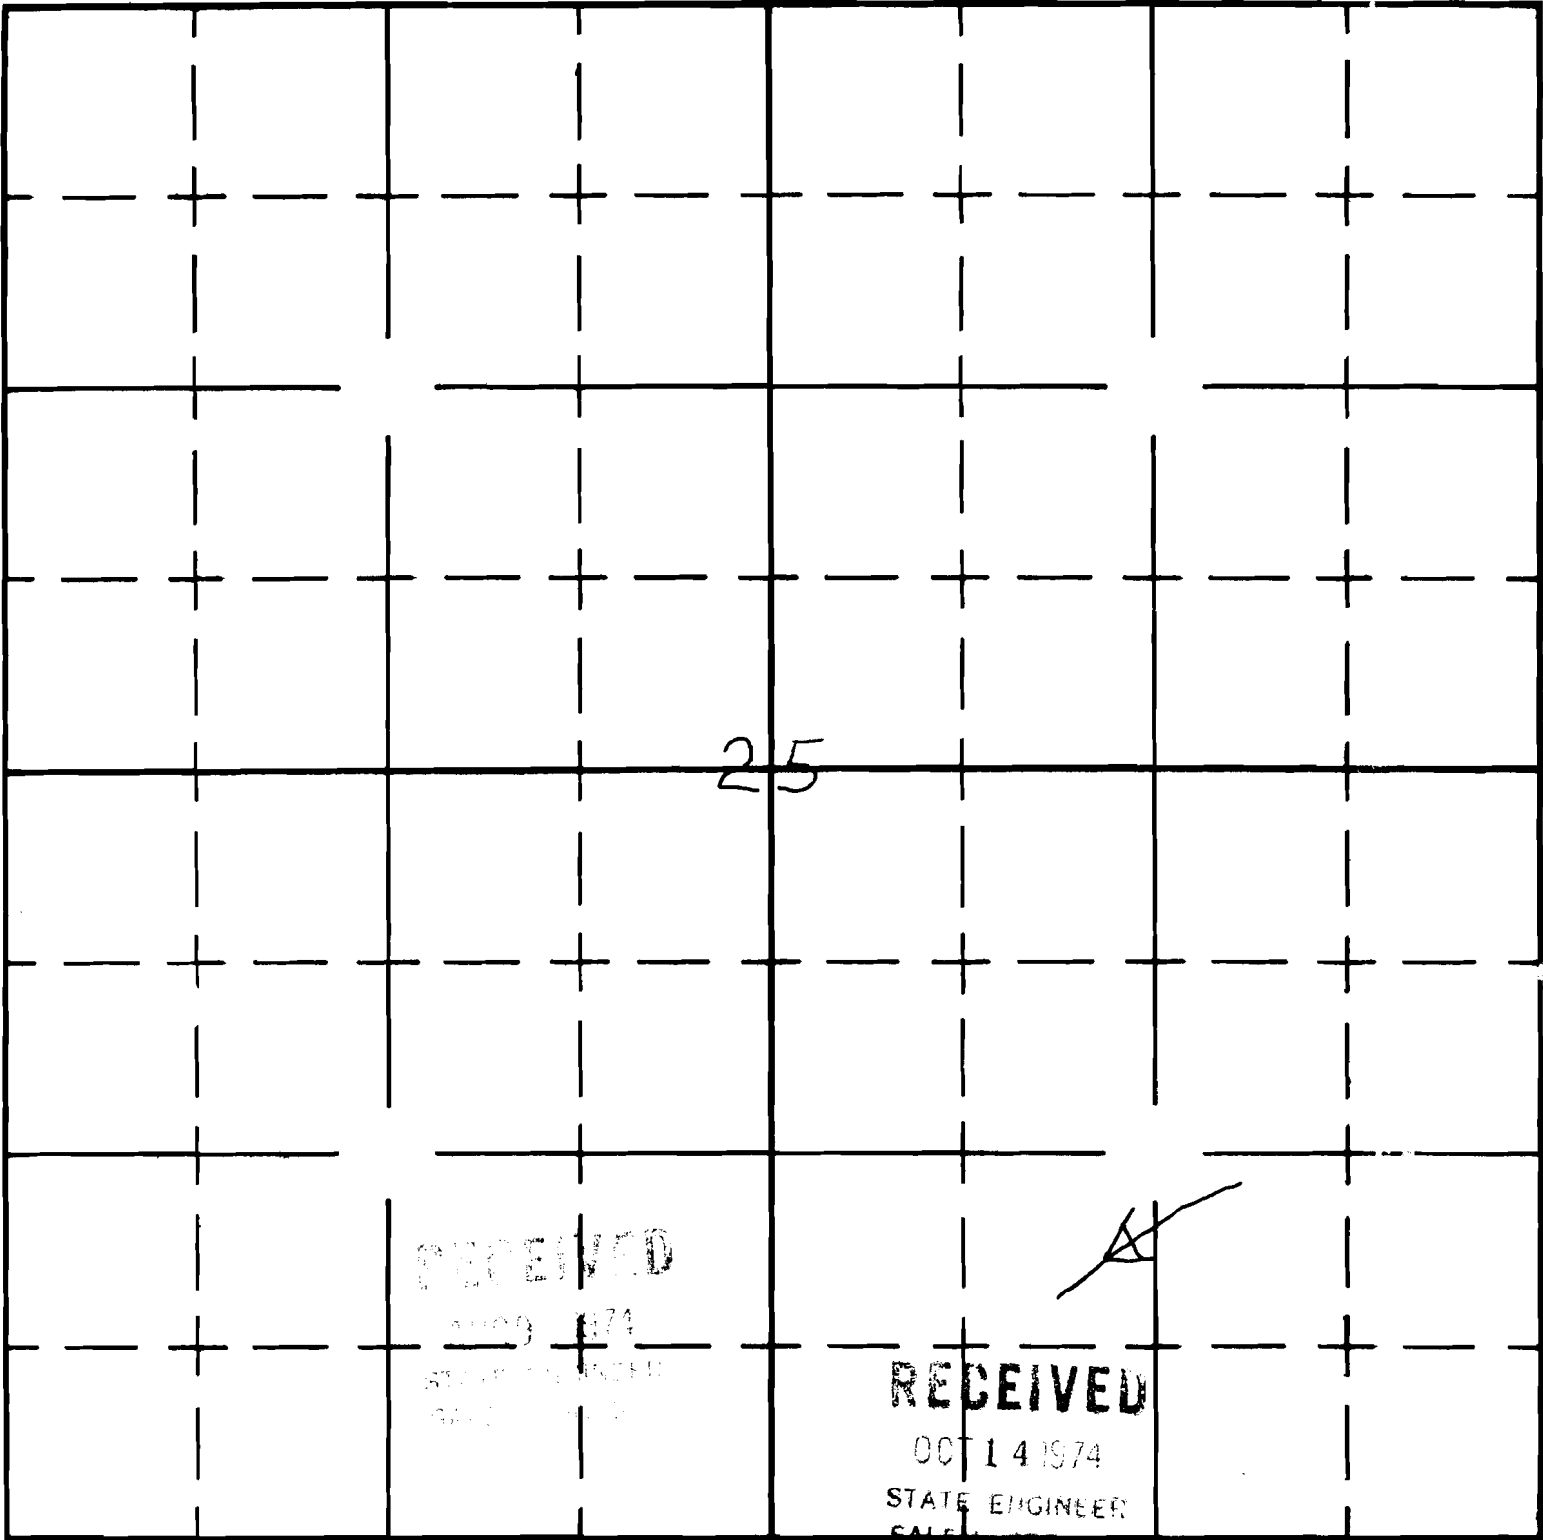

South