

UNITED STATES
DEPARTMENT OF THE INTERIOR
BUREAU OF LAND MANAGEMENT


SECTION 32

Oregon State Water Filings

TOWNSHIP 185, RANGE 40E, W. M.

Swamp Cr. Res

North

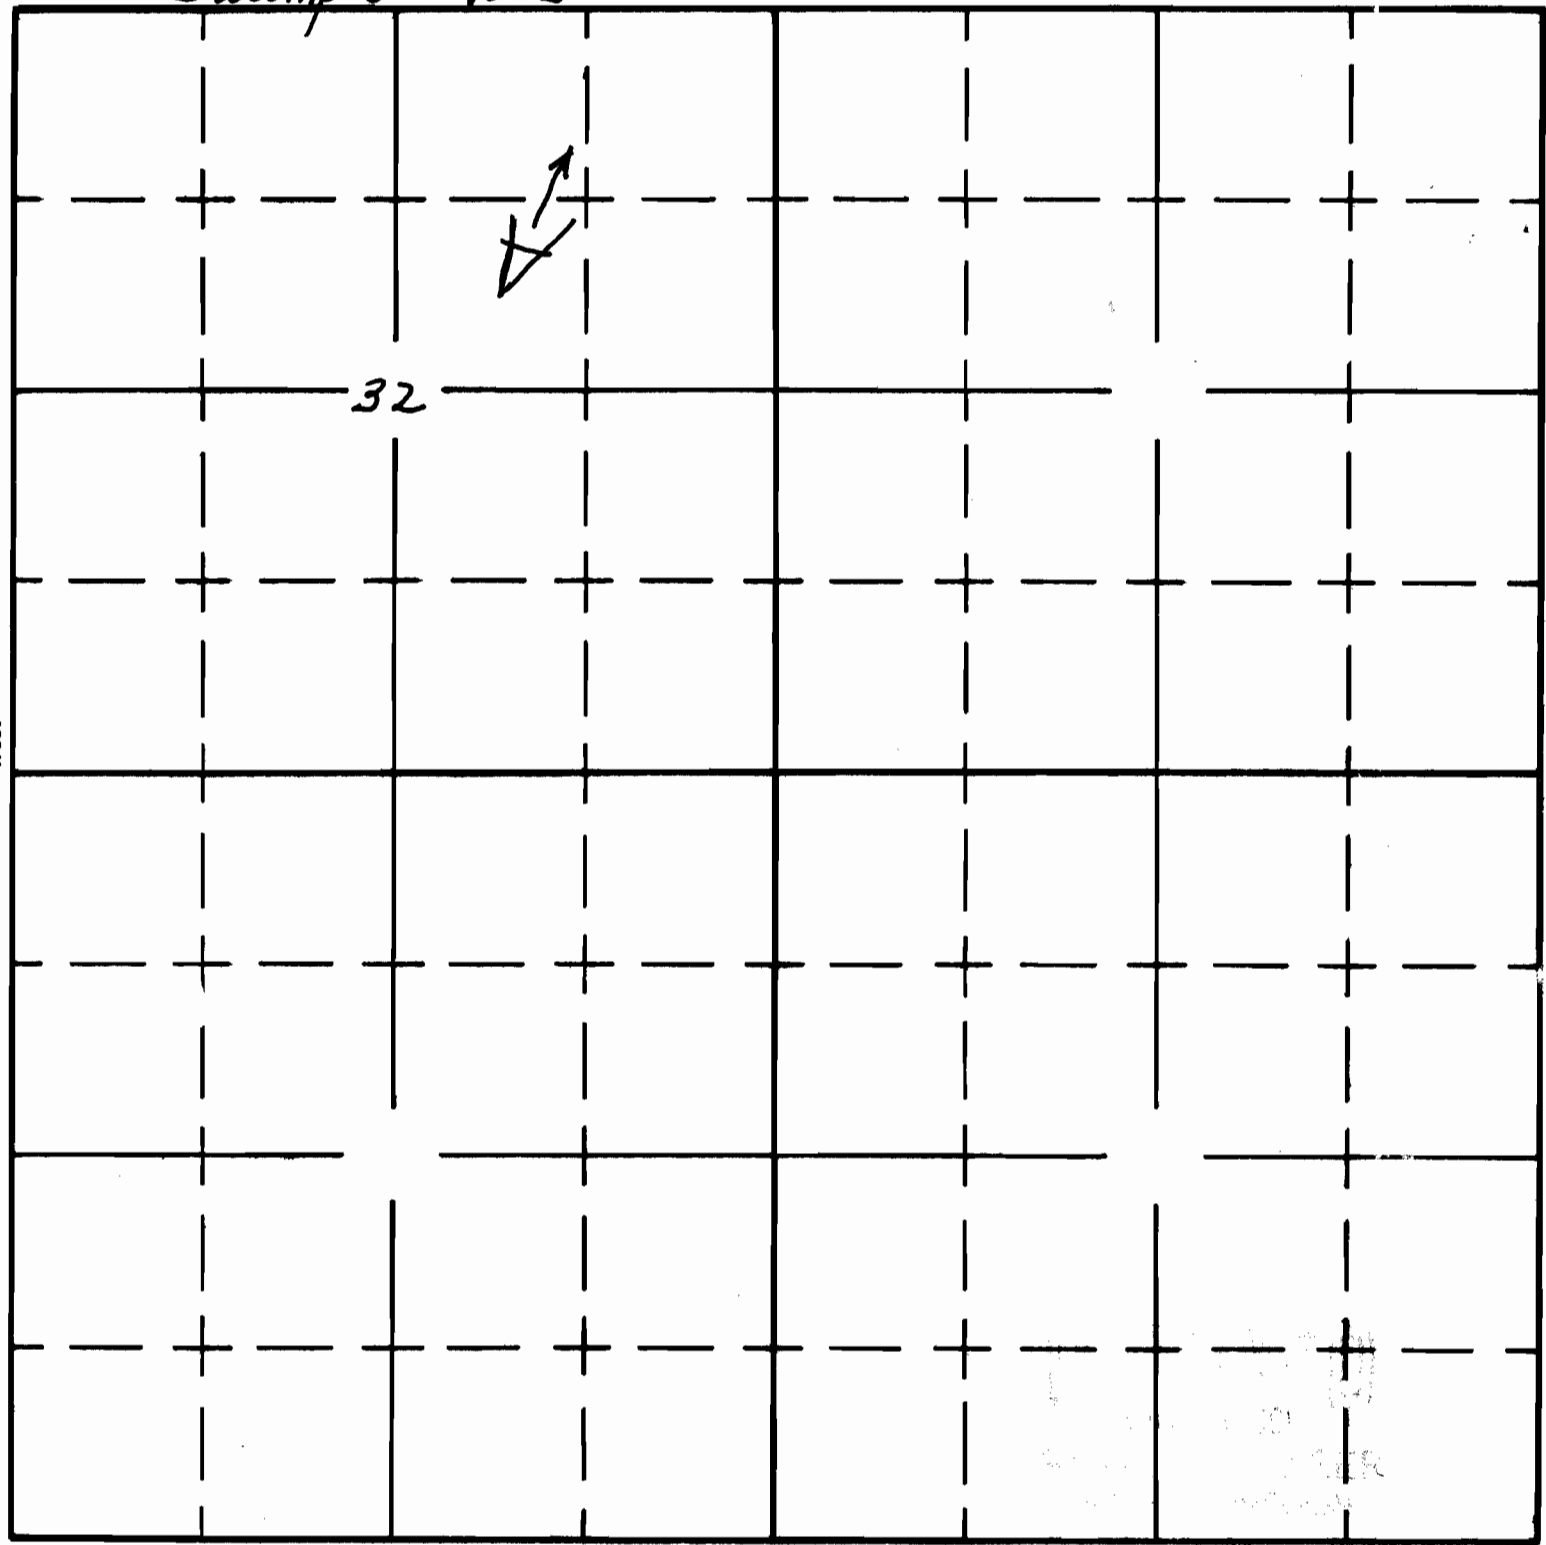

South

APPLICATION No. R-36922

PERMIT No. R 7921