

UNITED STATES
DEPARTMENT OF THE INTERIOR
BUREAU OF LAND MANAGEMENT


SECTION

Oregon State Water Filings

524

TOWNSHIP 315, RANGE 43E, W. M.

North

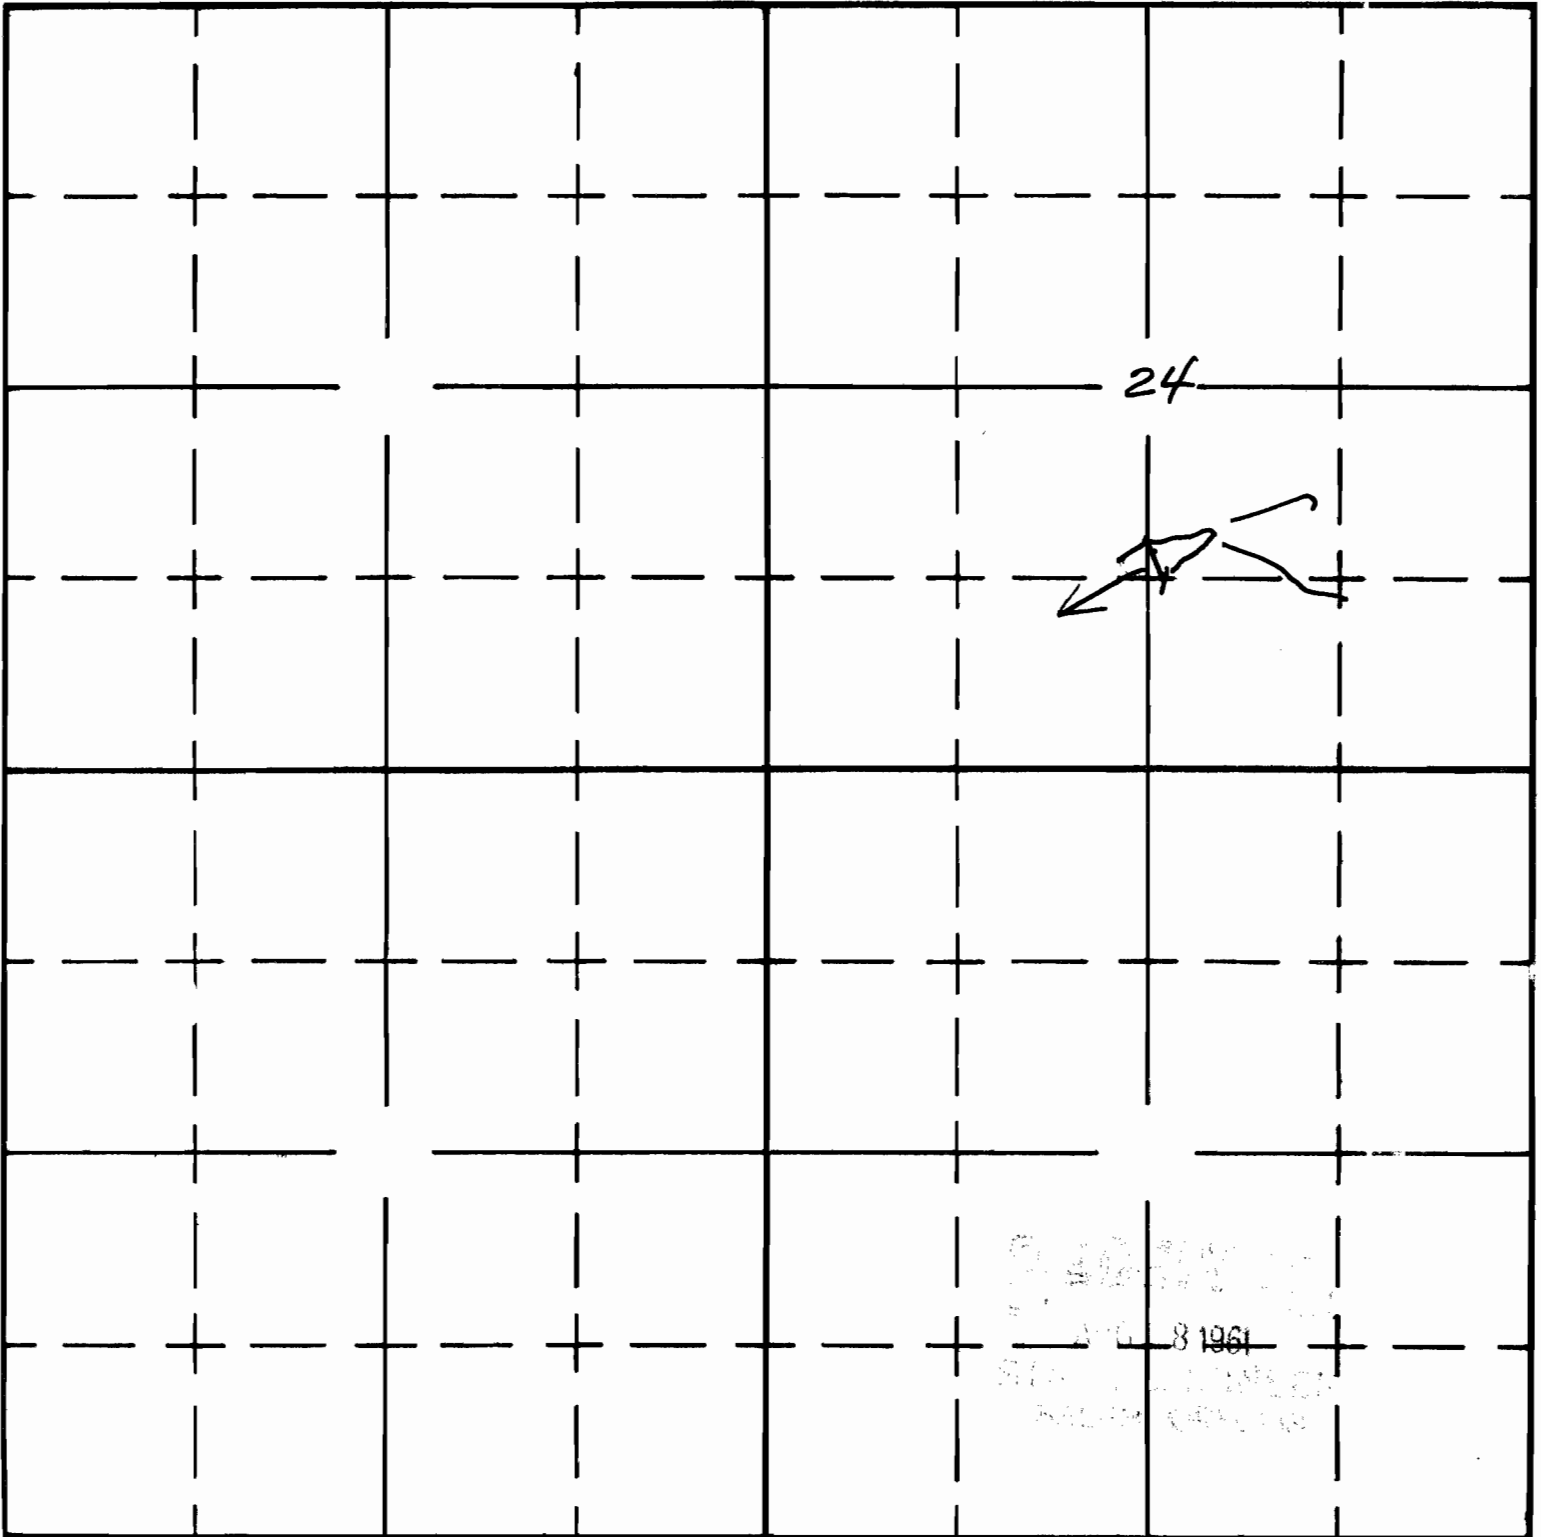

South

APPLICATION No. **R-36611**
PERMIT No. **R 7259**