

Form A1-187
March 1961

UNITED STATES
DEPARTMENT OF THE INTERIOR
BUREAU OF LAND MANAGEMENT


SECTION

S18

Oregon State Water Filings

TOWNSHIP 32S, RANGE 44E, W. M.

North

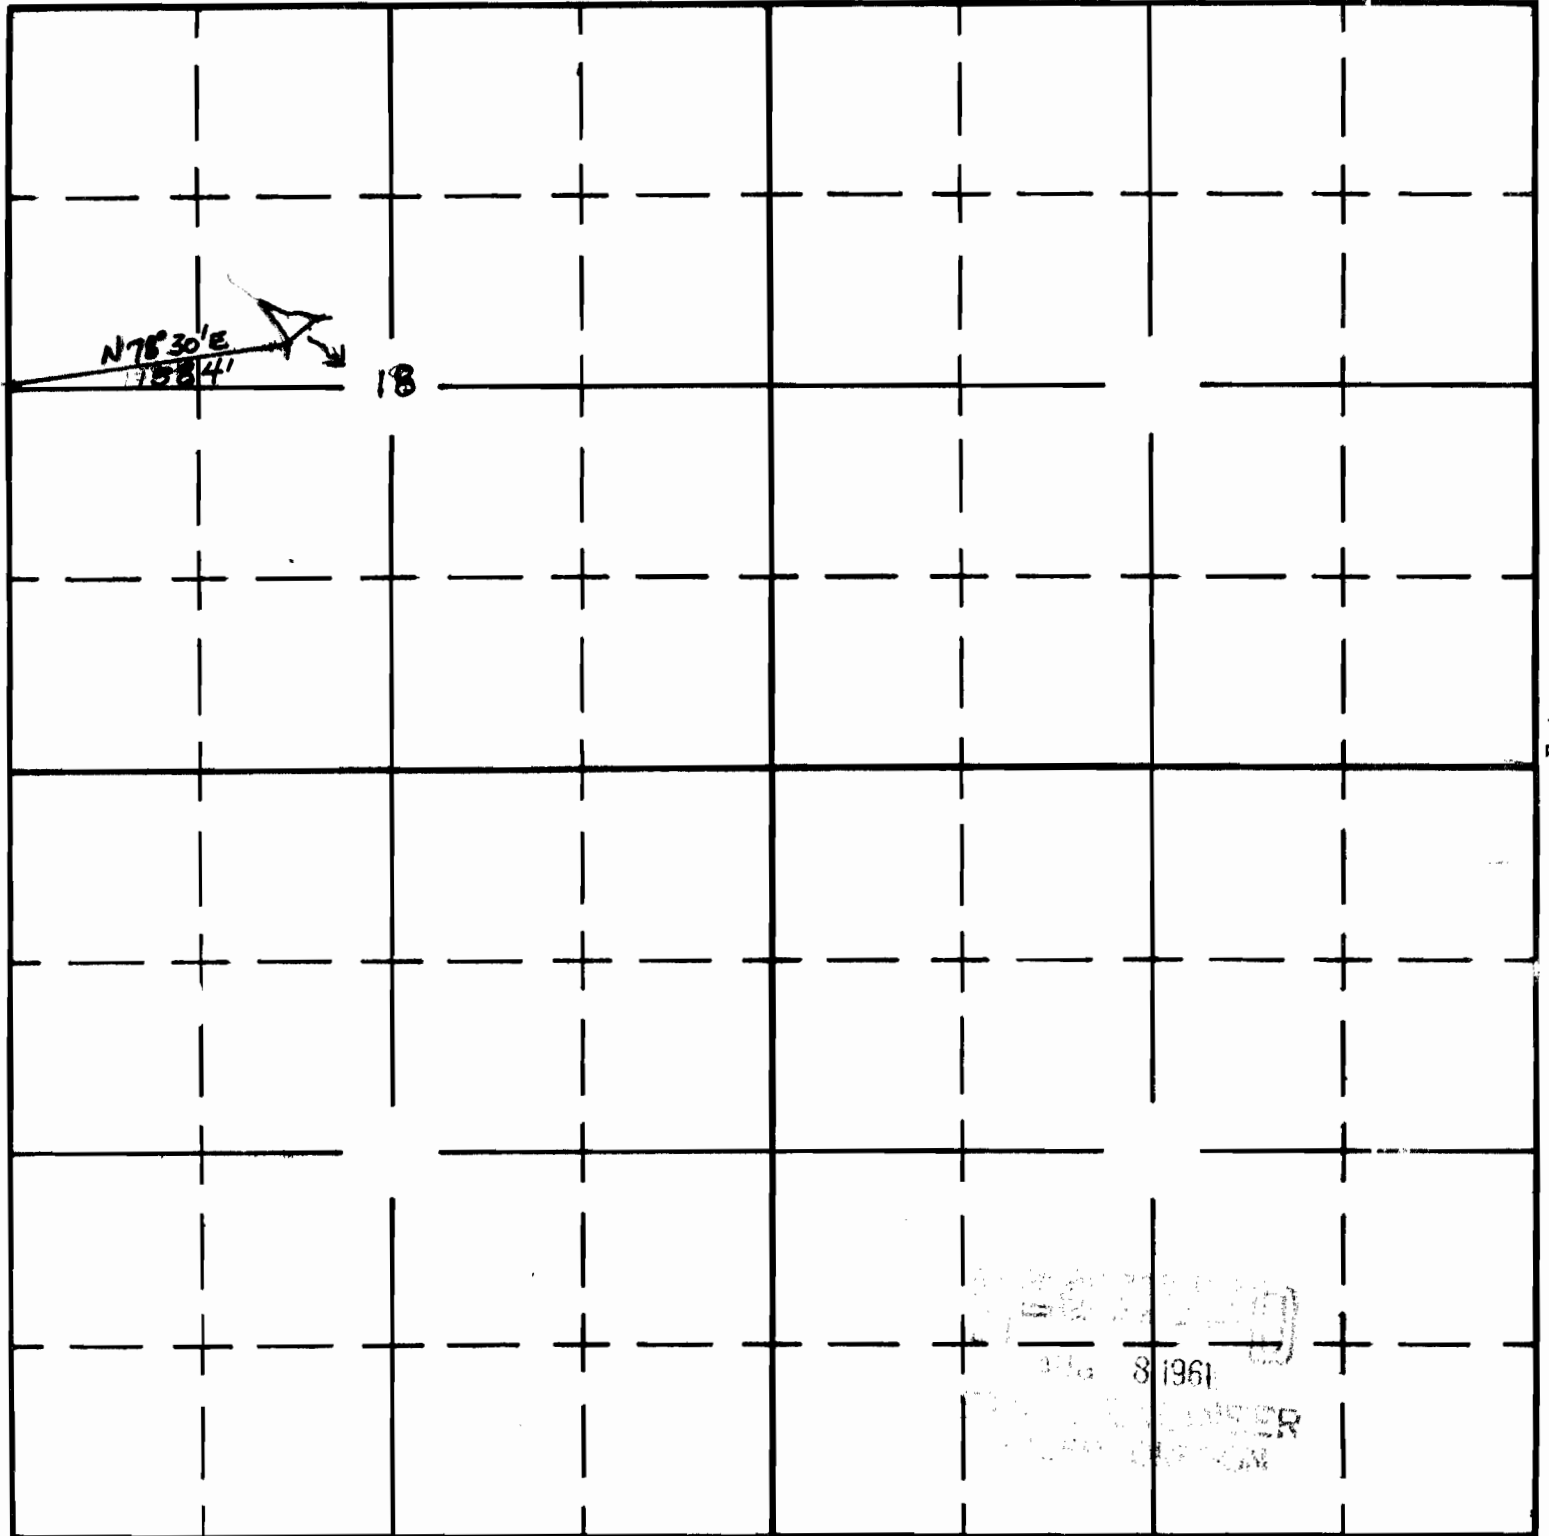

South

APPLICATION No. R-36625
PERMIT No. R-4260