


UNITED STATES
DEPARTMENT OF THE INTERIOR
BUREAU OF LAND MANAGEMENT

SECTION _____

Oregon State Water Filings

TOWNSHIP 20S, RANGE 37E, W. M.

North

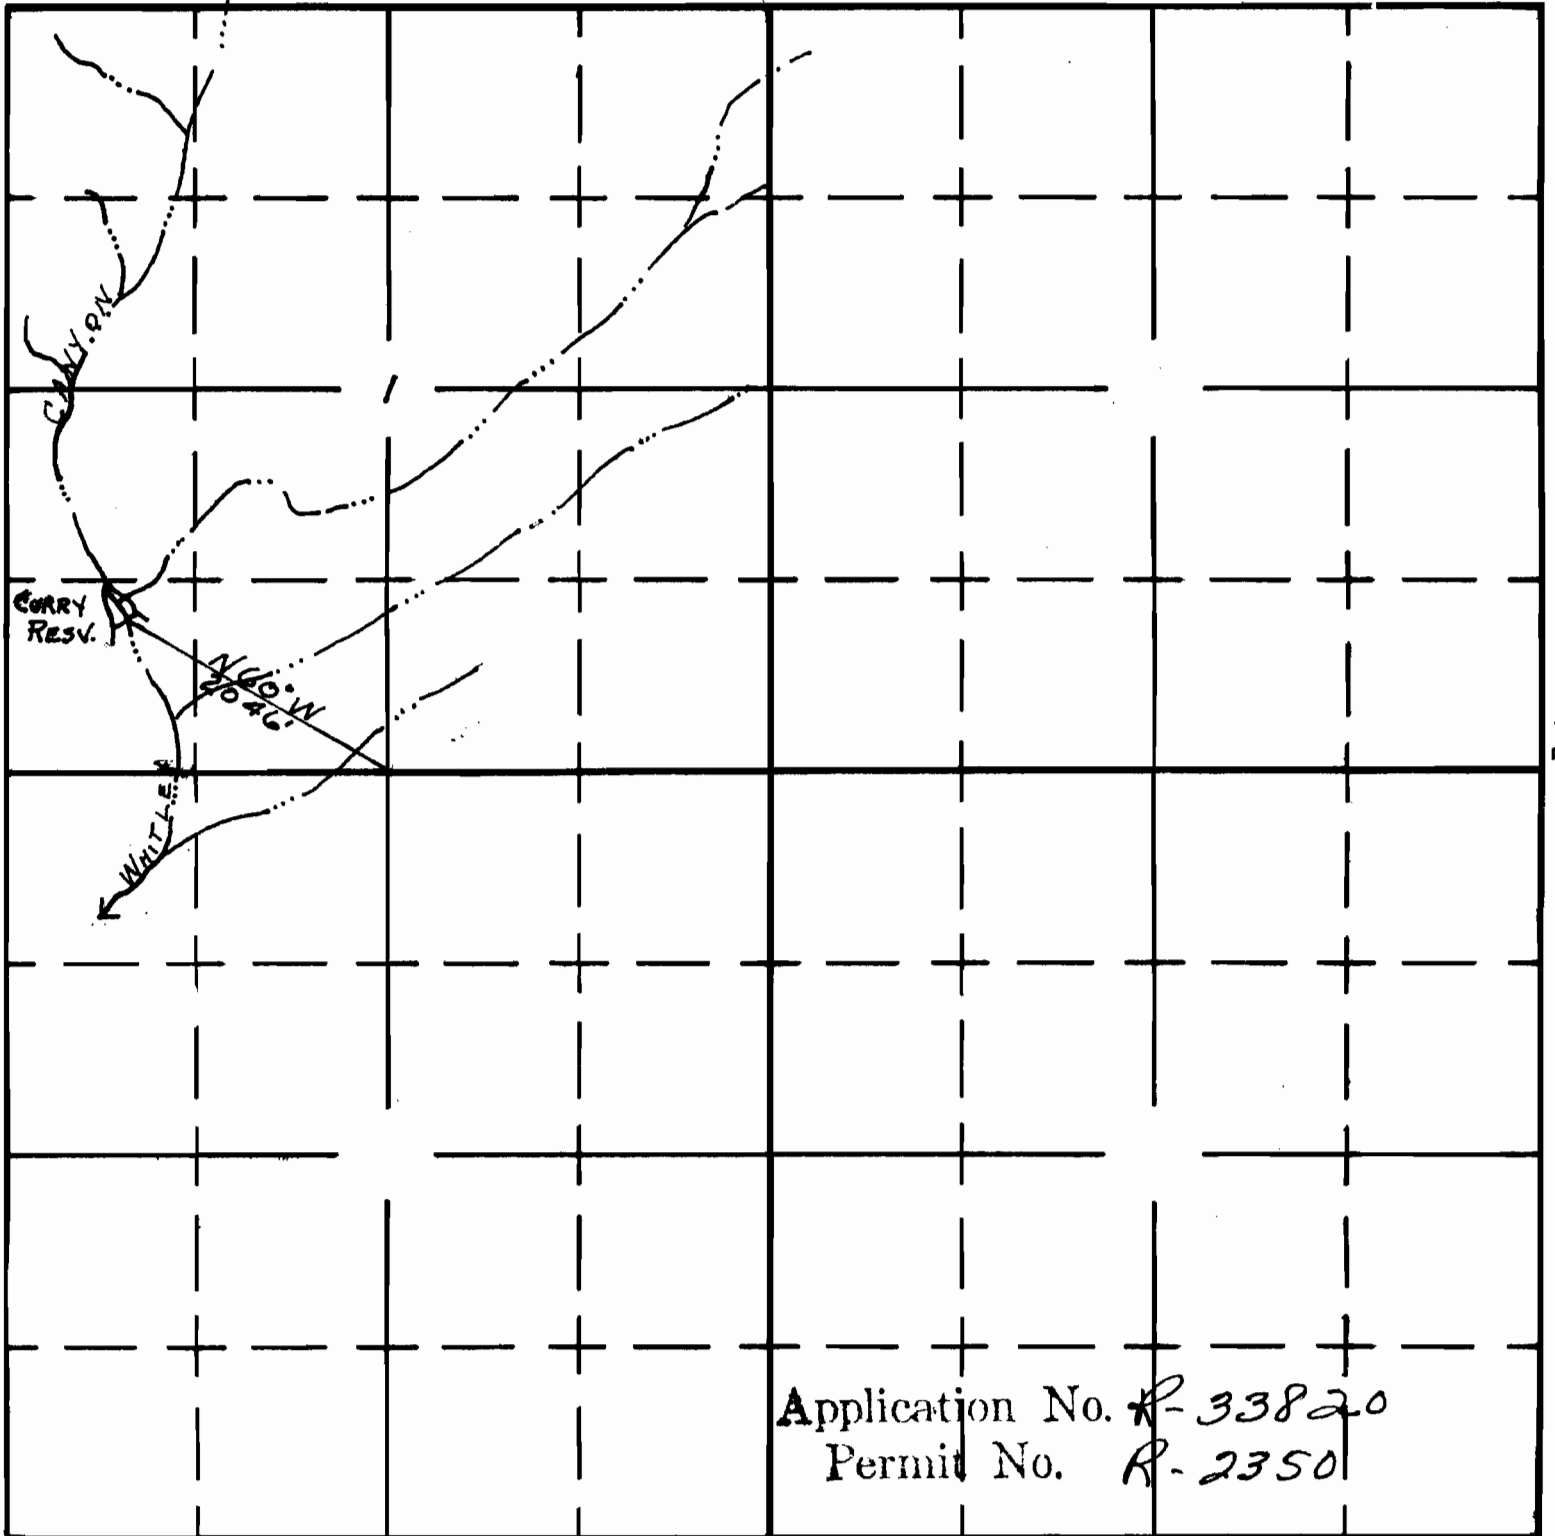

South

Application No. R-33820
Permit No. R-2350

APPLICATION No.
PERMIT No.