

Form AI-187
March 1961

UNITED STATES
DEPARTMENT OF THE INTERIOR
BUREAU OF LAND MANAGEMENT

SECTION


Oregon State Water Filings

14

TOWNSHIP 24S, RANGE 45E, W. M.

Coyote Res

North

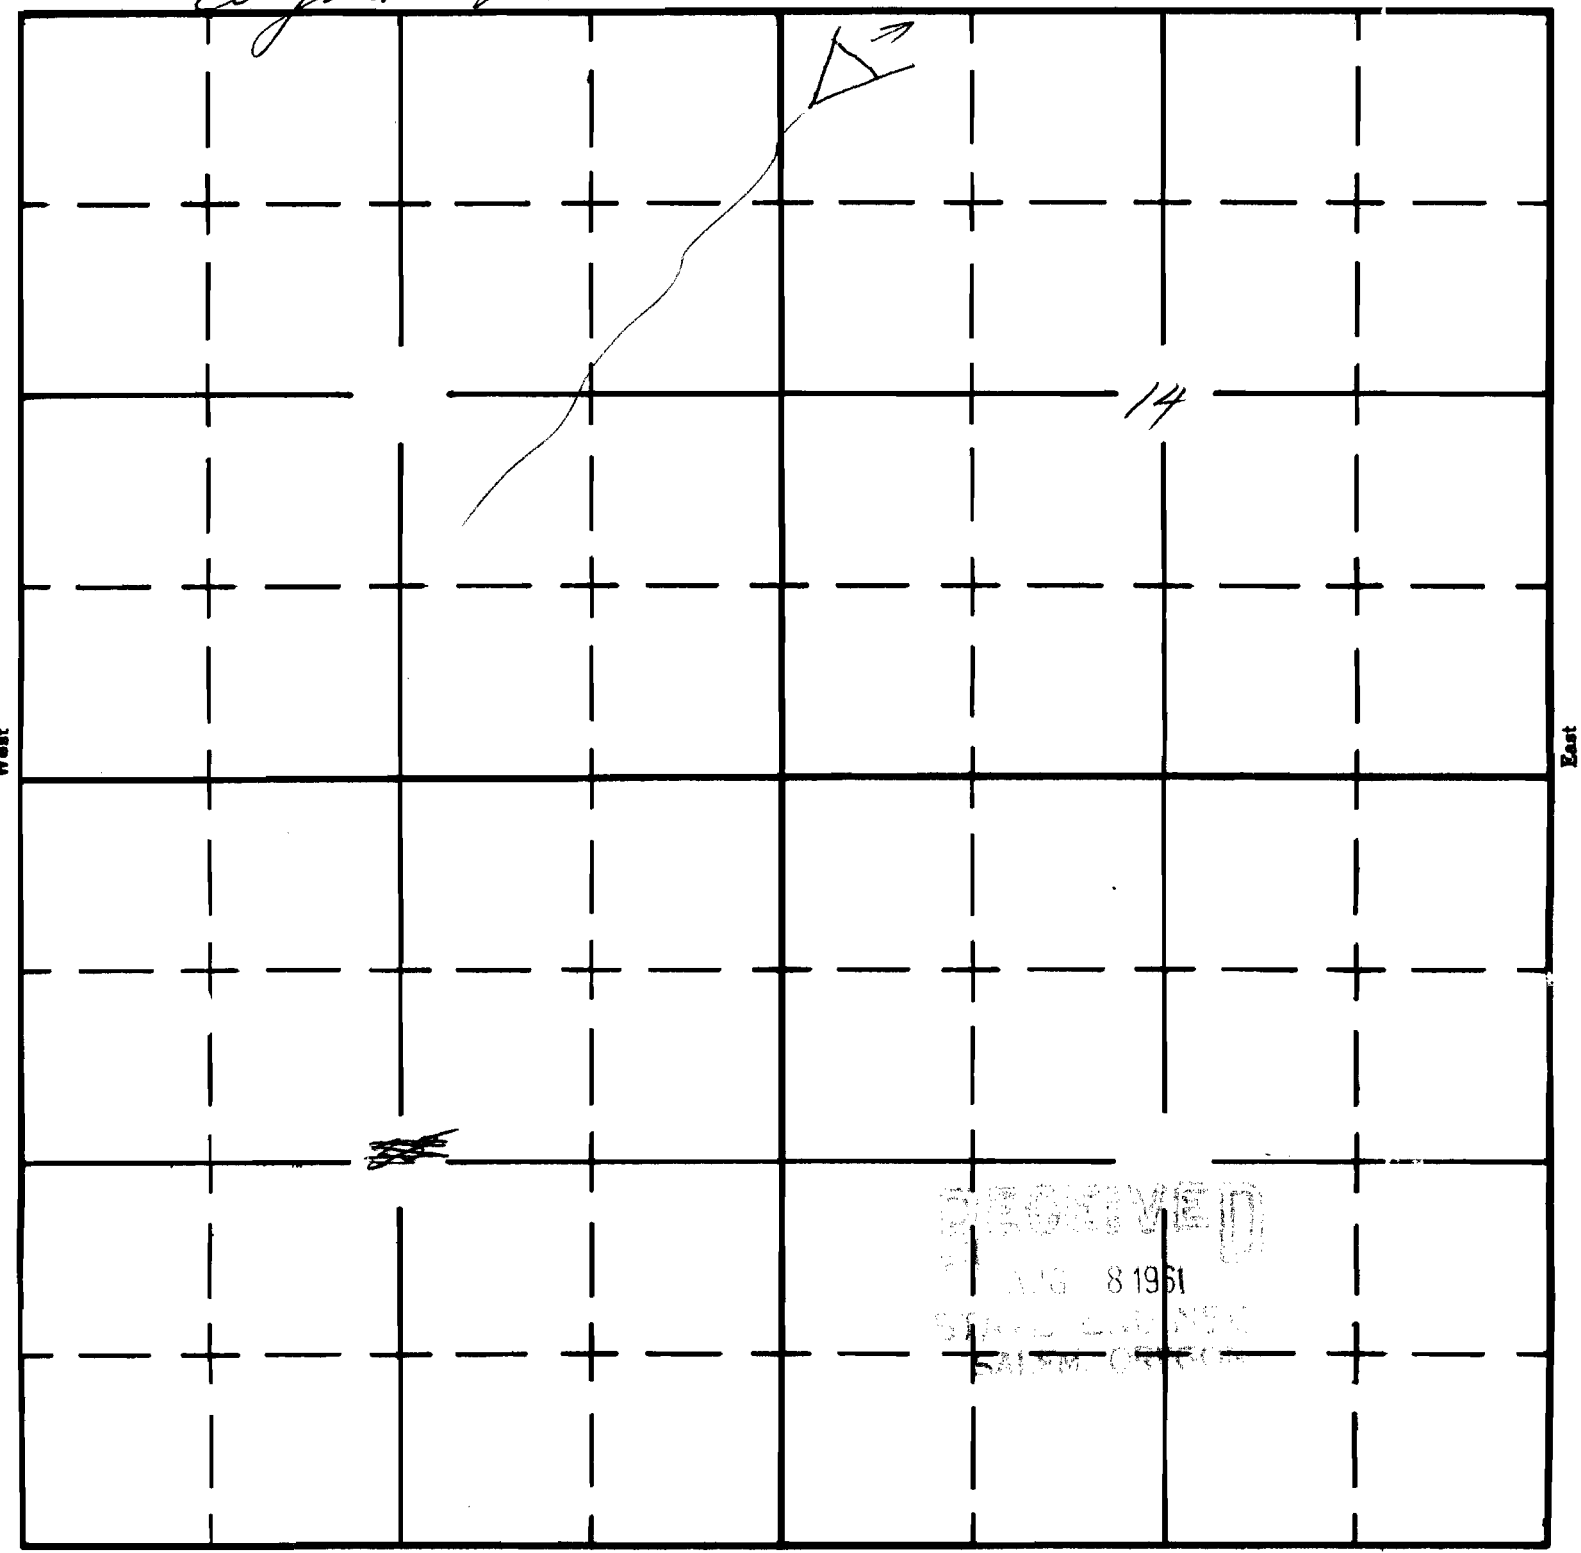

Approx 3 1/2 miles drainage area

South

APPLICATION No. **R-36657**
PERMIT No. **R-4267**