

UNITED STATES
DEPARTMENT OF THE INTERIOR
BUREAU OF LAND MANAGEMENT

SECTION


23

Oregon State Water Filings

TOWNSHIP 22S, RANGE 15E, W. M.

Chamy Res

North

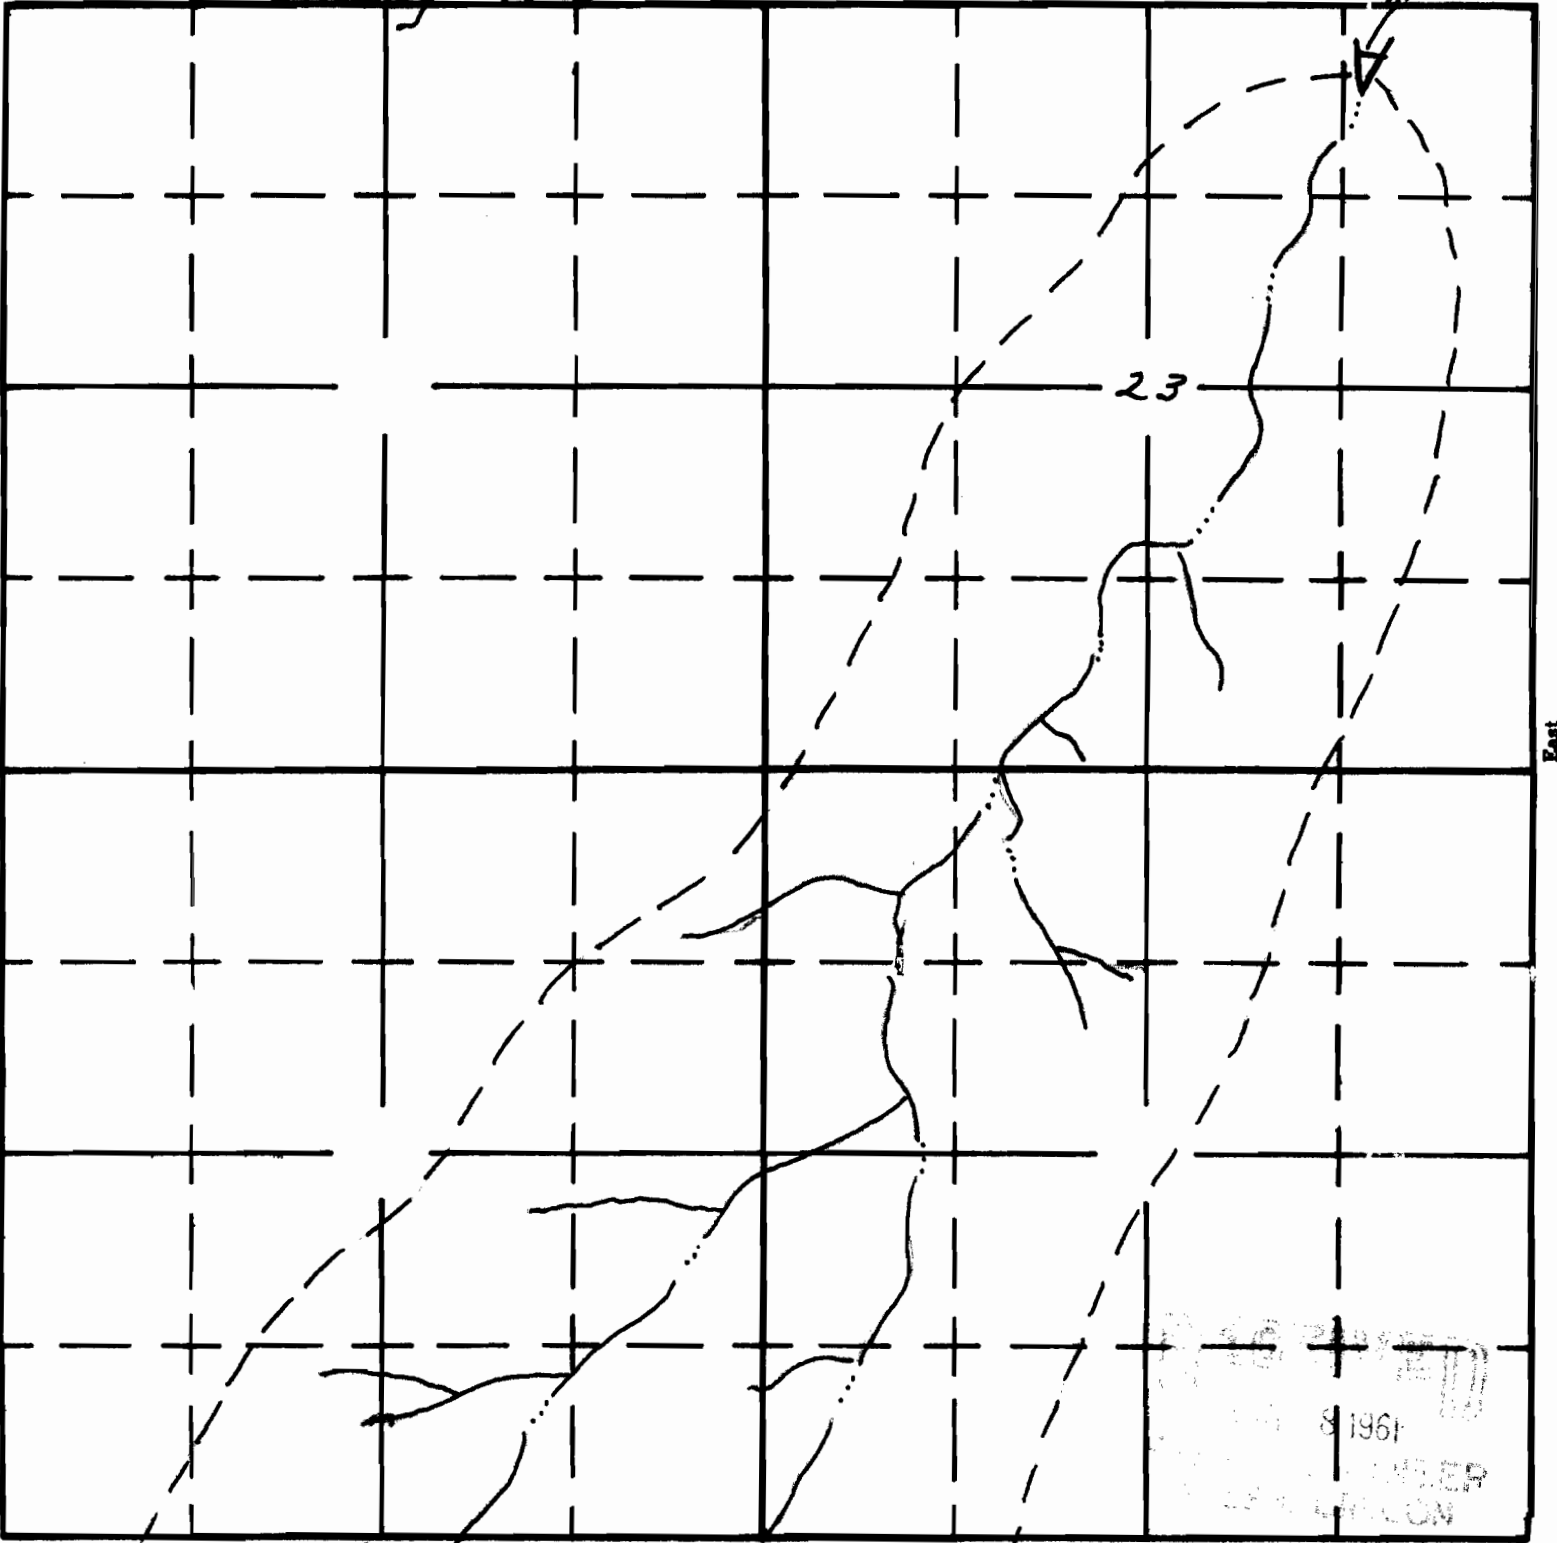

Drainage Area
Approx. 2 sq. mi.

RECEIVED
MAY 8 1961
REGISTERED
DEPT. OF AGRICULTURE
OREGON

APPLICATION No. **R-36658**
PERMIT No. **R-4268**