

UNITED STATES
DEPARTMENT OF THE INTERIOR
BUREAU OF LAND MANAGEMENT

Mud Lake Res.

SECTION


Oregon State Water Filings

S 31

TOWNSHIP 28 S, RANGE 43 E, W. M.

Mud Lake Res #2

North

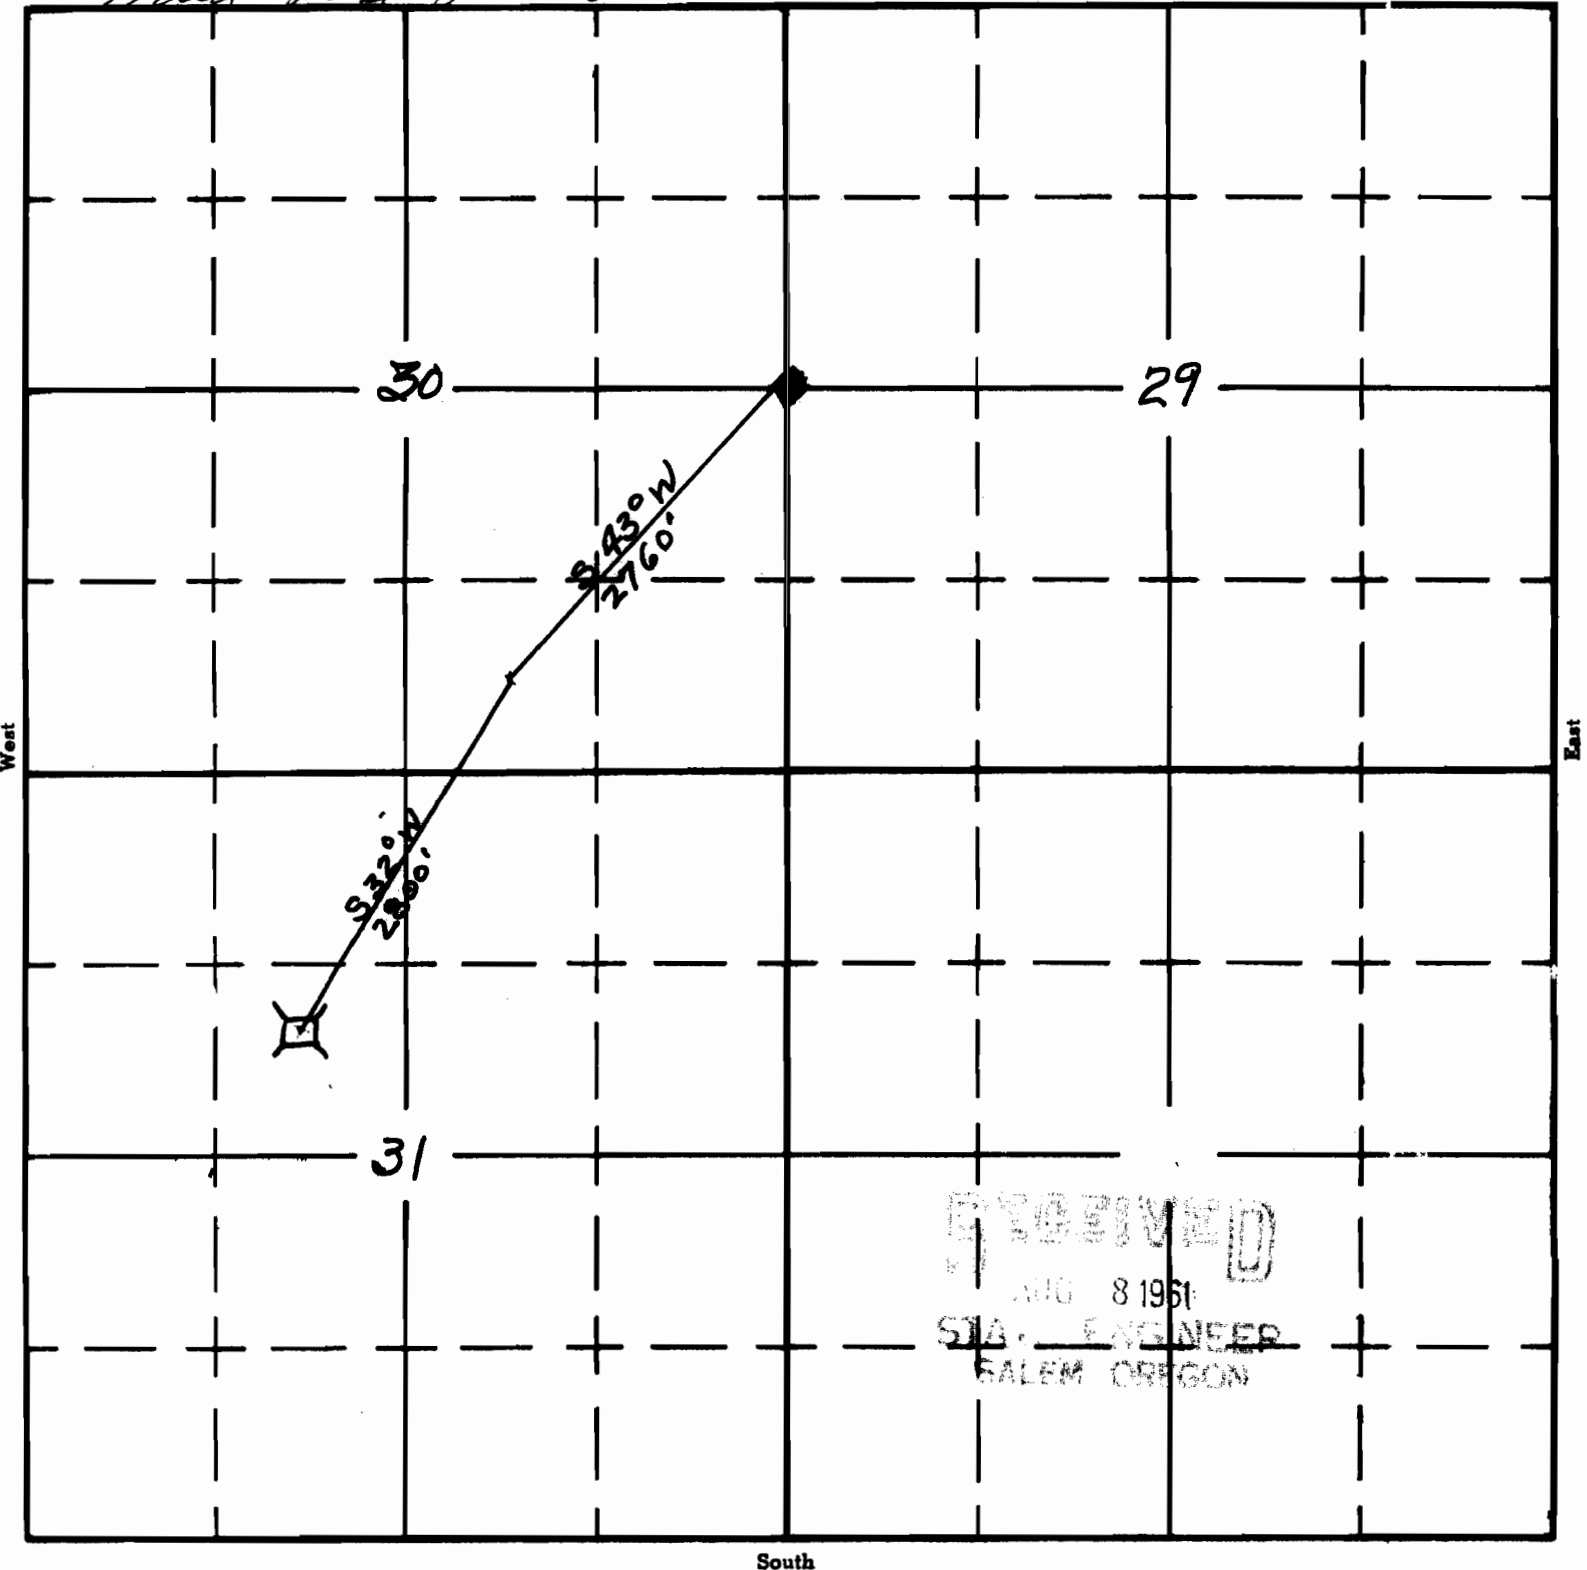

APPLICATION No. R-36712

PERMIT No. R-4278