

UNITED STATES
DEPARTMENT OF THE INTERIOR
BUREAU OF LAND MANAGEMENT


SECTION

Oregon State Water Filings

S 20

TOWNSHIP 29S, RANGE 45E, W. M.

Box Canyon Reservoir ^{North}

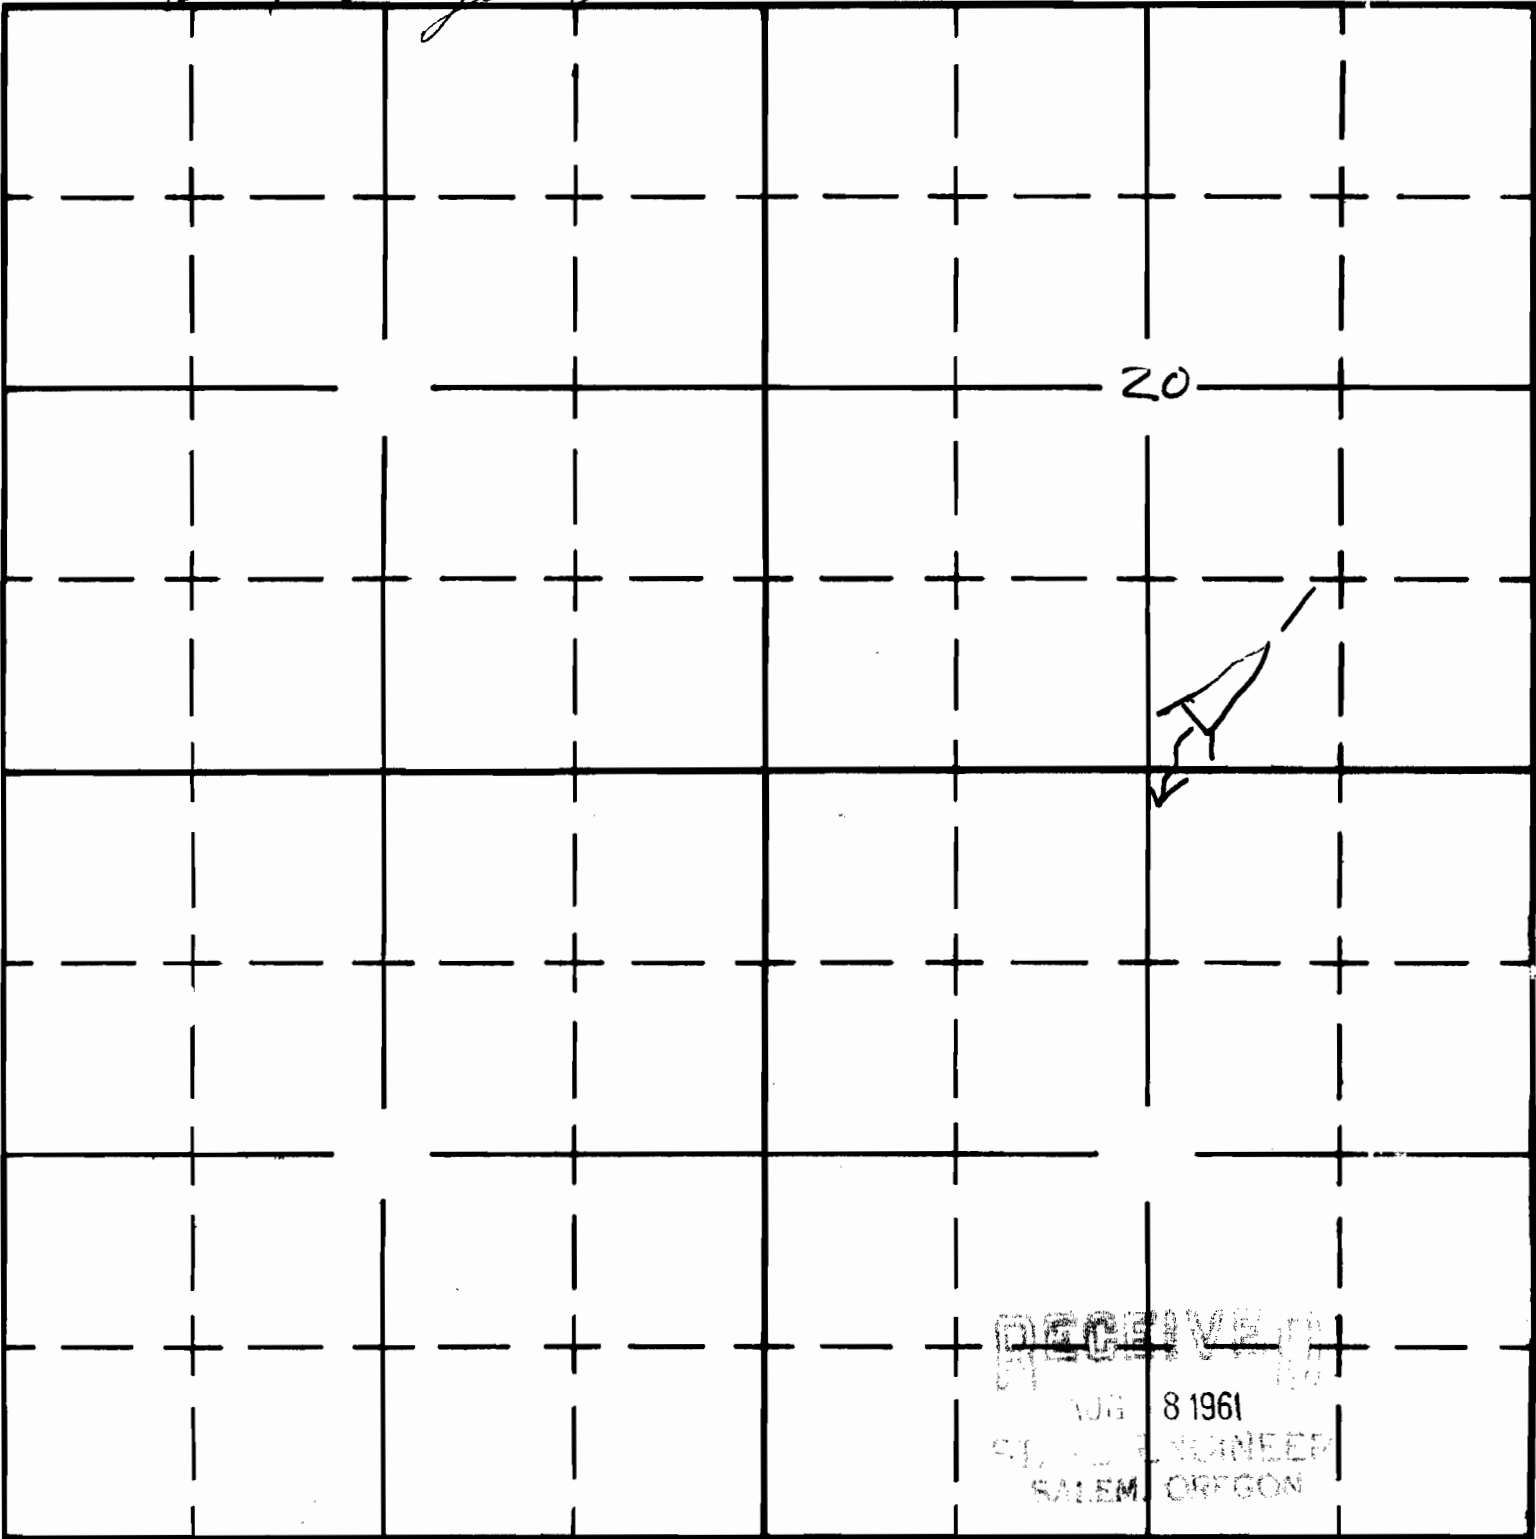

South