

Form AI-187
March 1961

UNITED STATES
DEPARTMENT OF THE INTERIOR
BUREAU OF LAND MANAGEMENT

SECTION


Oregon State Water Filings

32

TOWNSHIP 29 S, RANGE 4 E, W. M.

White Wash Res.

North

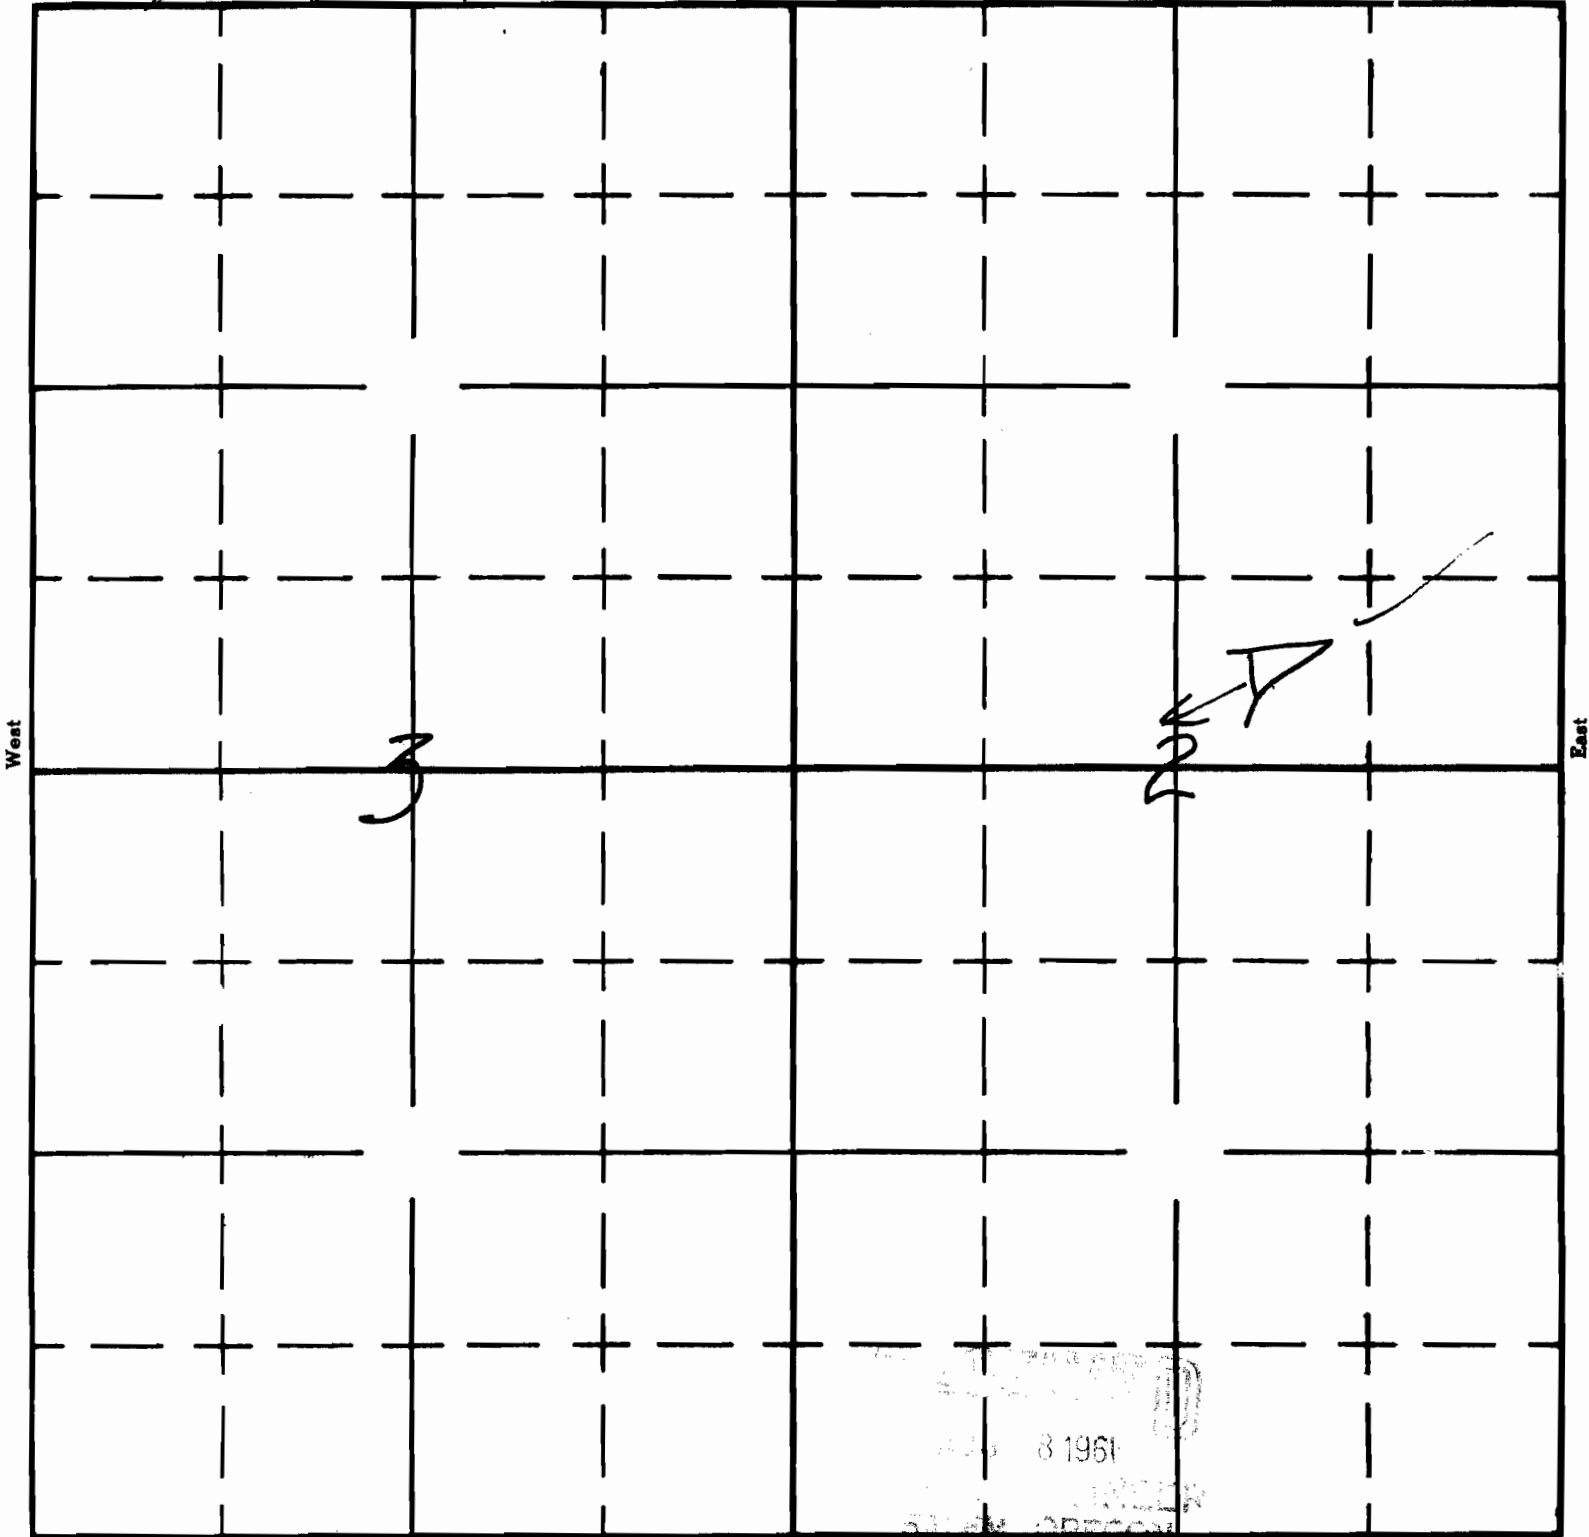

West

East

South

APPLICATION No. **R-36749**

PERMIT No. **R-4311**