

Form A1-187
March 1961

UNITED STATES
DEPARTMENT OF THE INTERIOR
BUREAU OF LAND MANAGEMENT

SECTION


14

Oregon State Water Filings

TOWNSHIP 23S, RANGE 40E, W. M.

Red Basin Res.

North

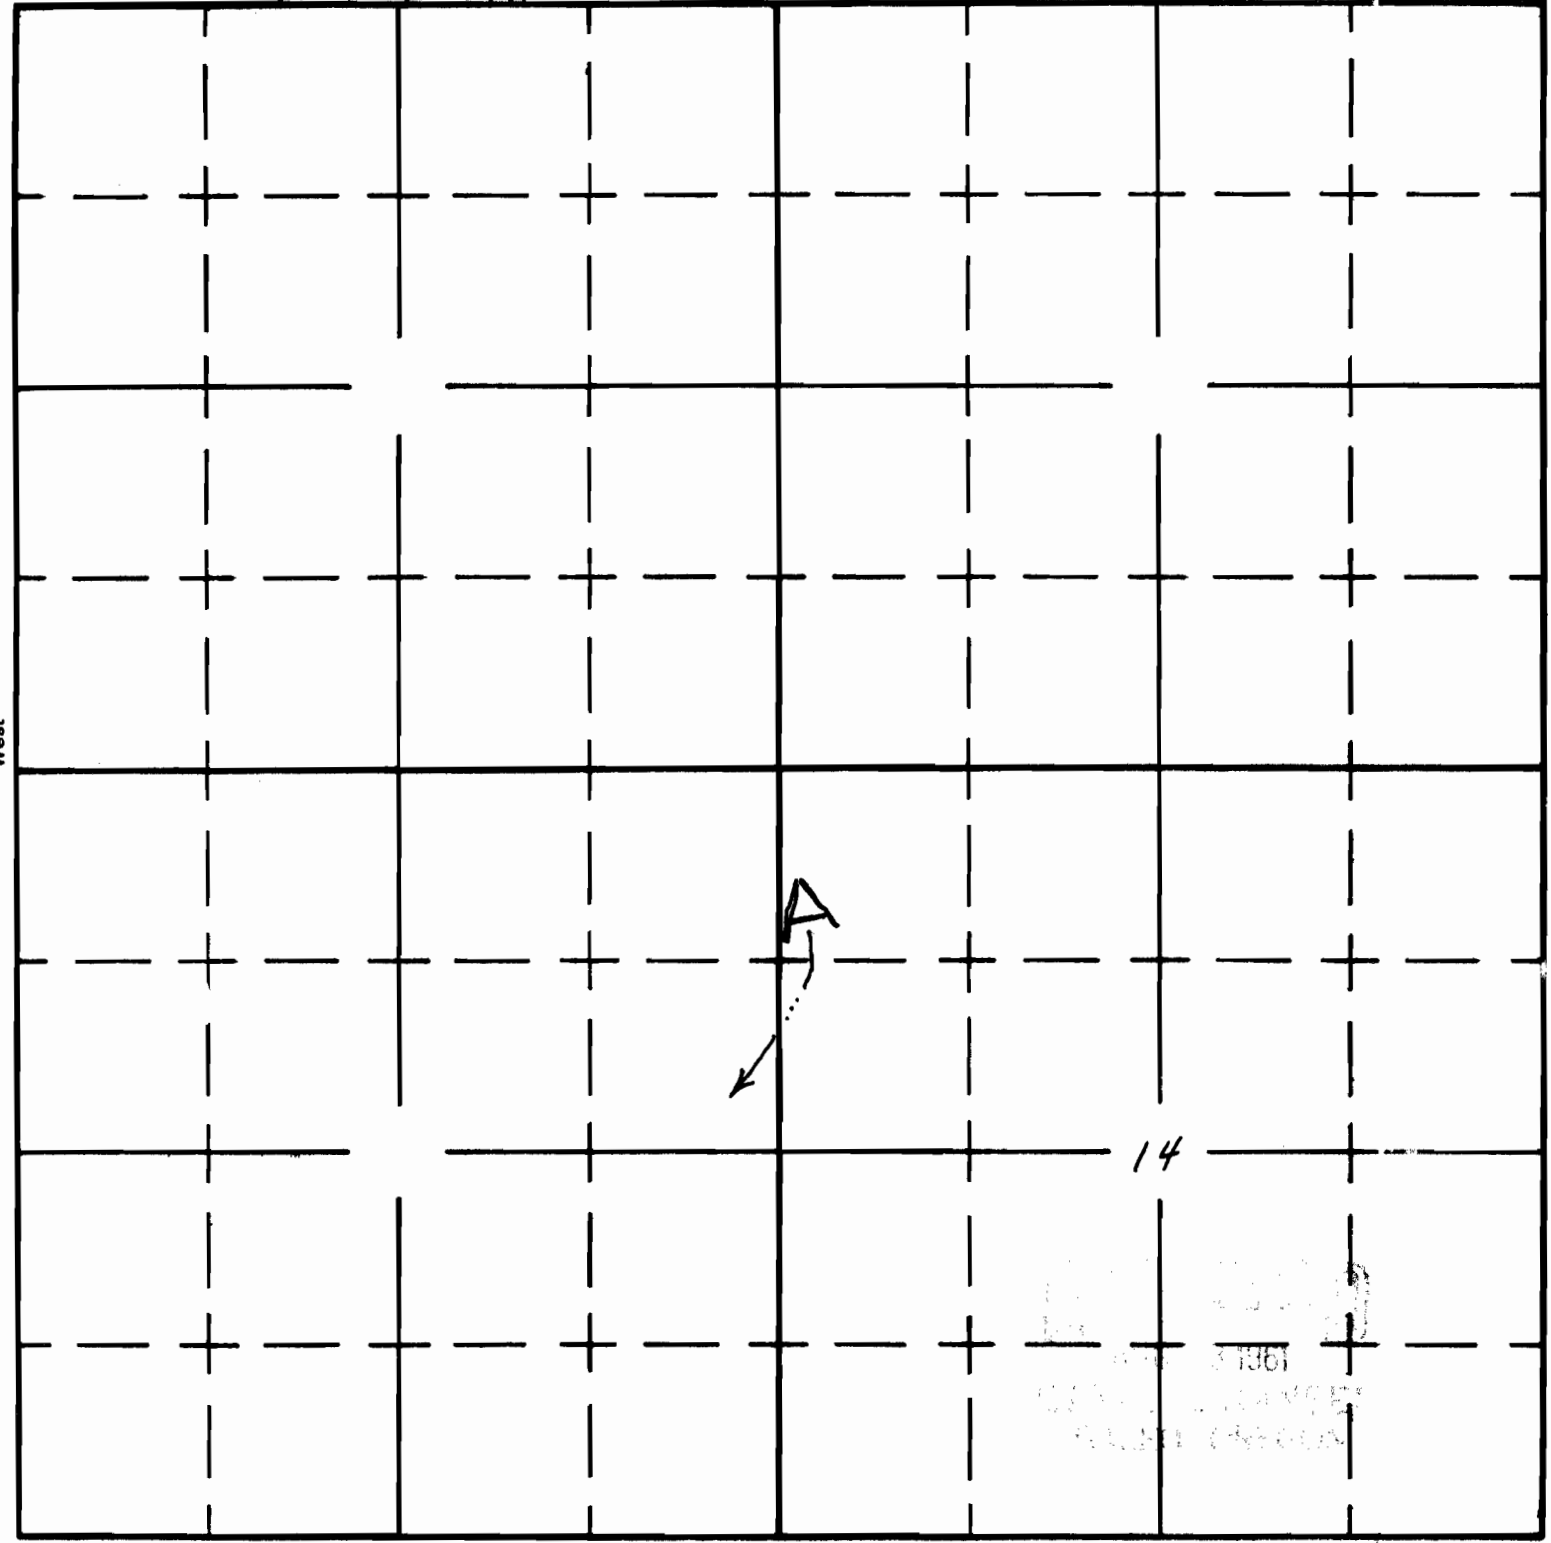

14

South

Drainage Area Approx. 3/4 sq. mi.

APPLICATION No. **R-36780**
PERMIT No. **R-4329**