

Form A1-187
March 1961


UNITED STATES
DEPARTMENT OF THE INTERIOR
BUREAU OF LAND MANAGEMENT

SECTION

Oregon State Water Filings

TOWNSHIP 36S, RANGE 48E, W. M.

Bay Fork Res North

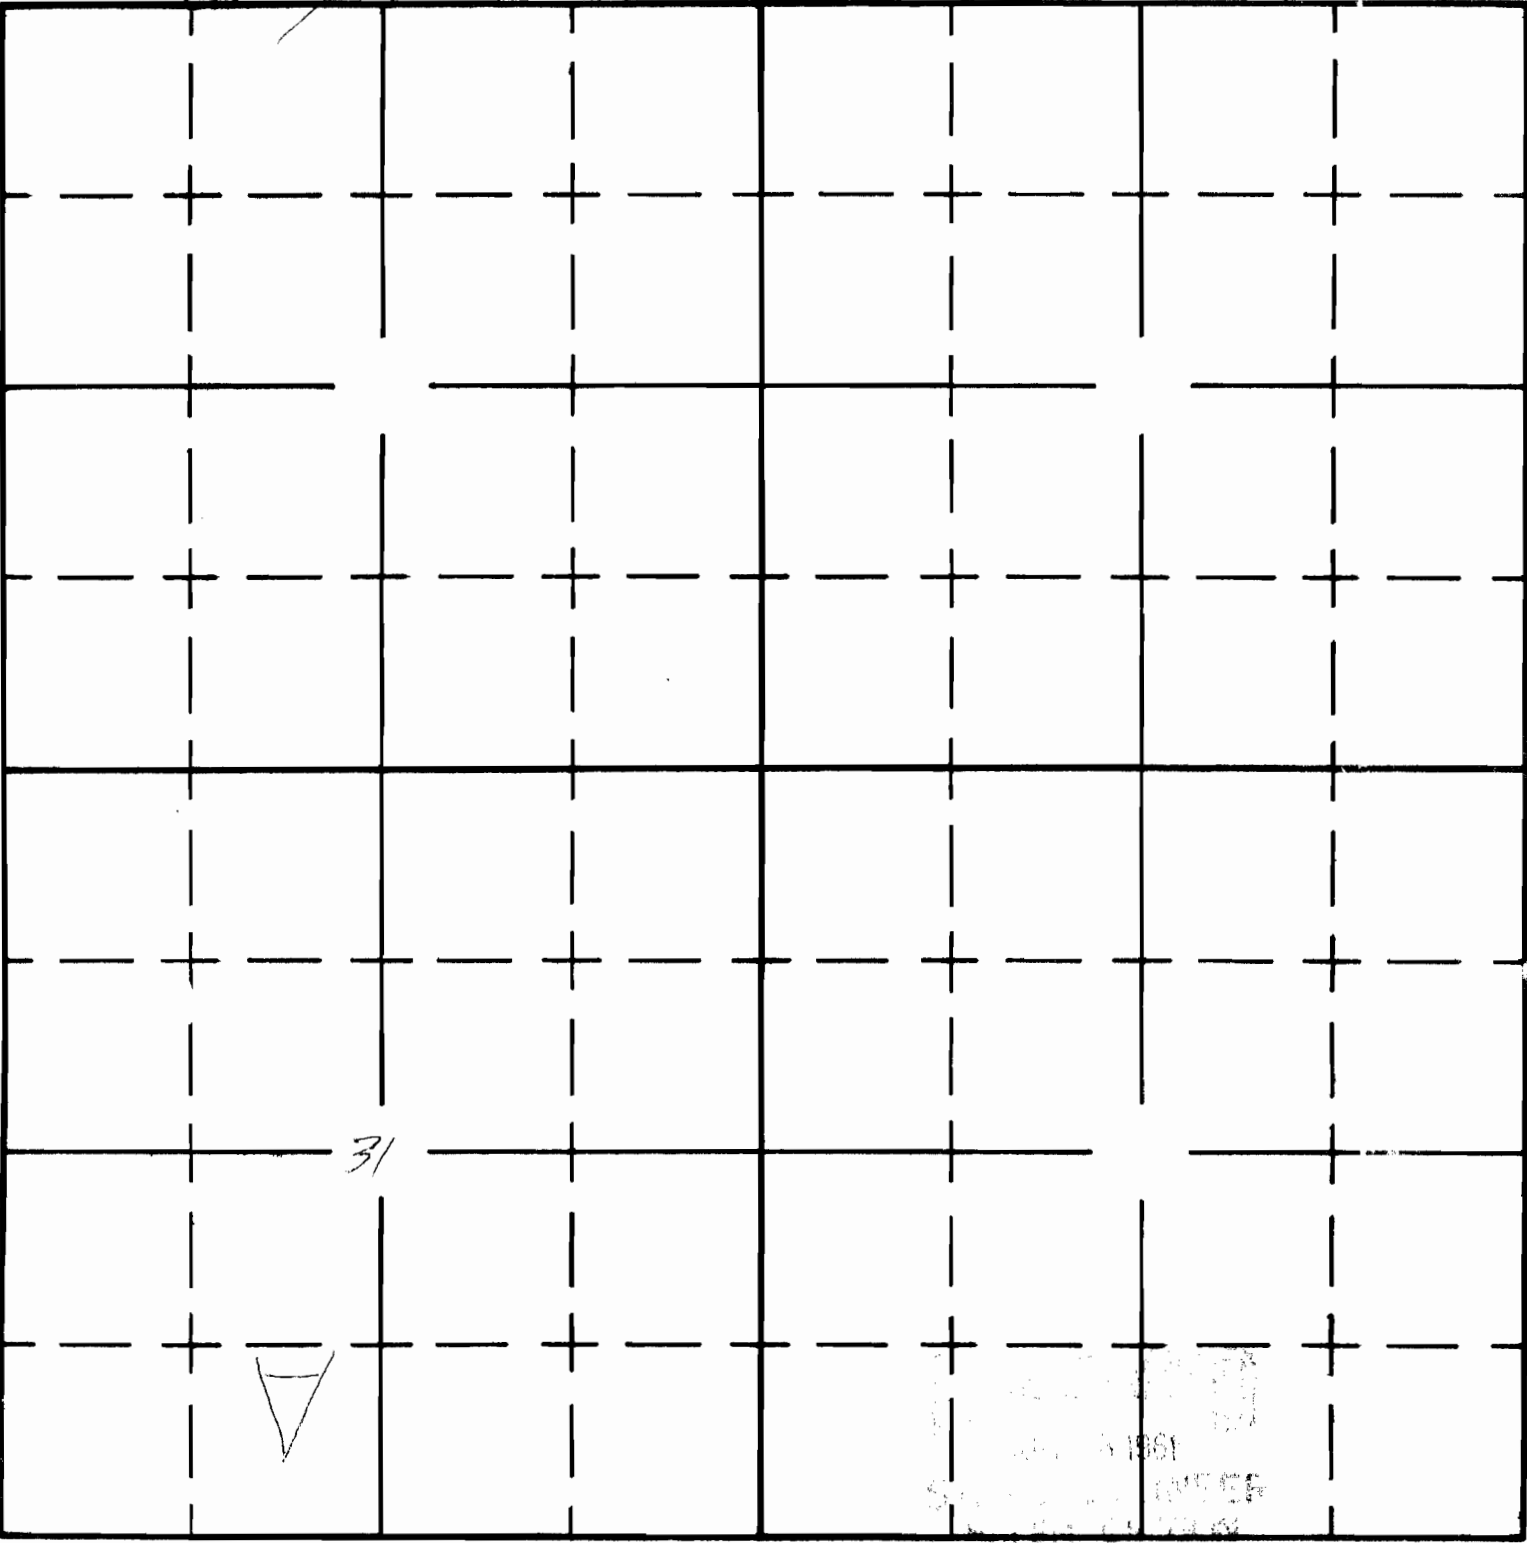

West

East

South

APPLICATION No. R-36789
PERMIT No. R-4336