


UNITED STATES
DEPARTMENT OF THE INTERIOR
BUREAU OF LAND MANAGEMENT

SECTION 30 **Oregon State Water Filings**

TOWNSHIP 34S, RANGE 43E, W. M.

Peacock Pond Res.

North

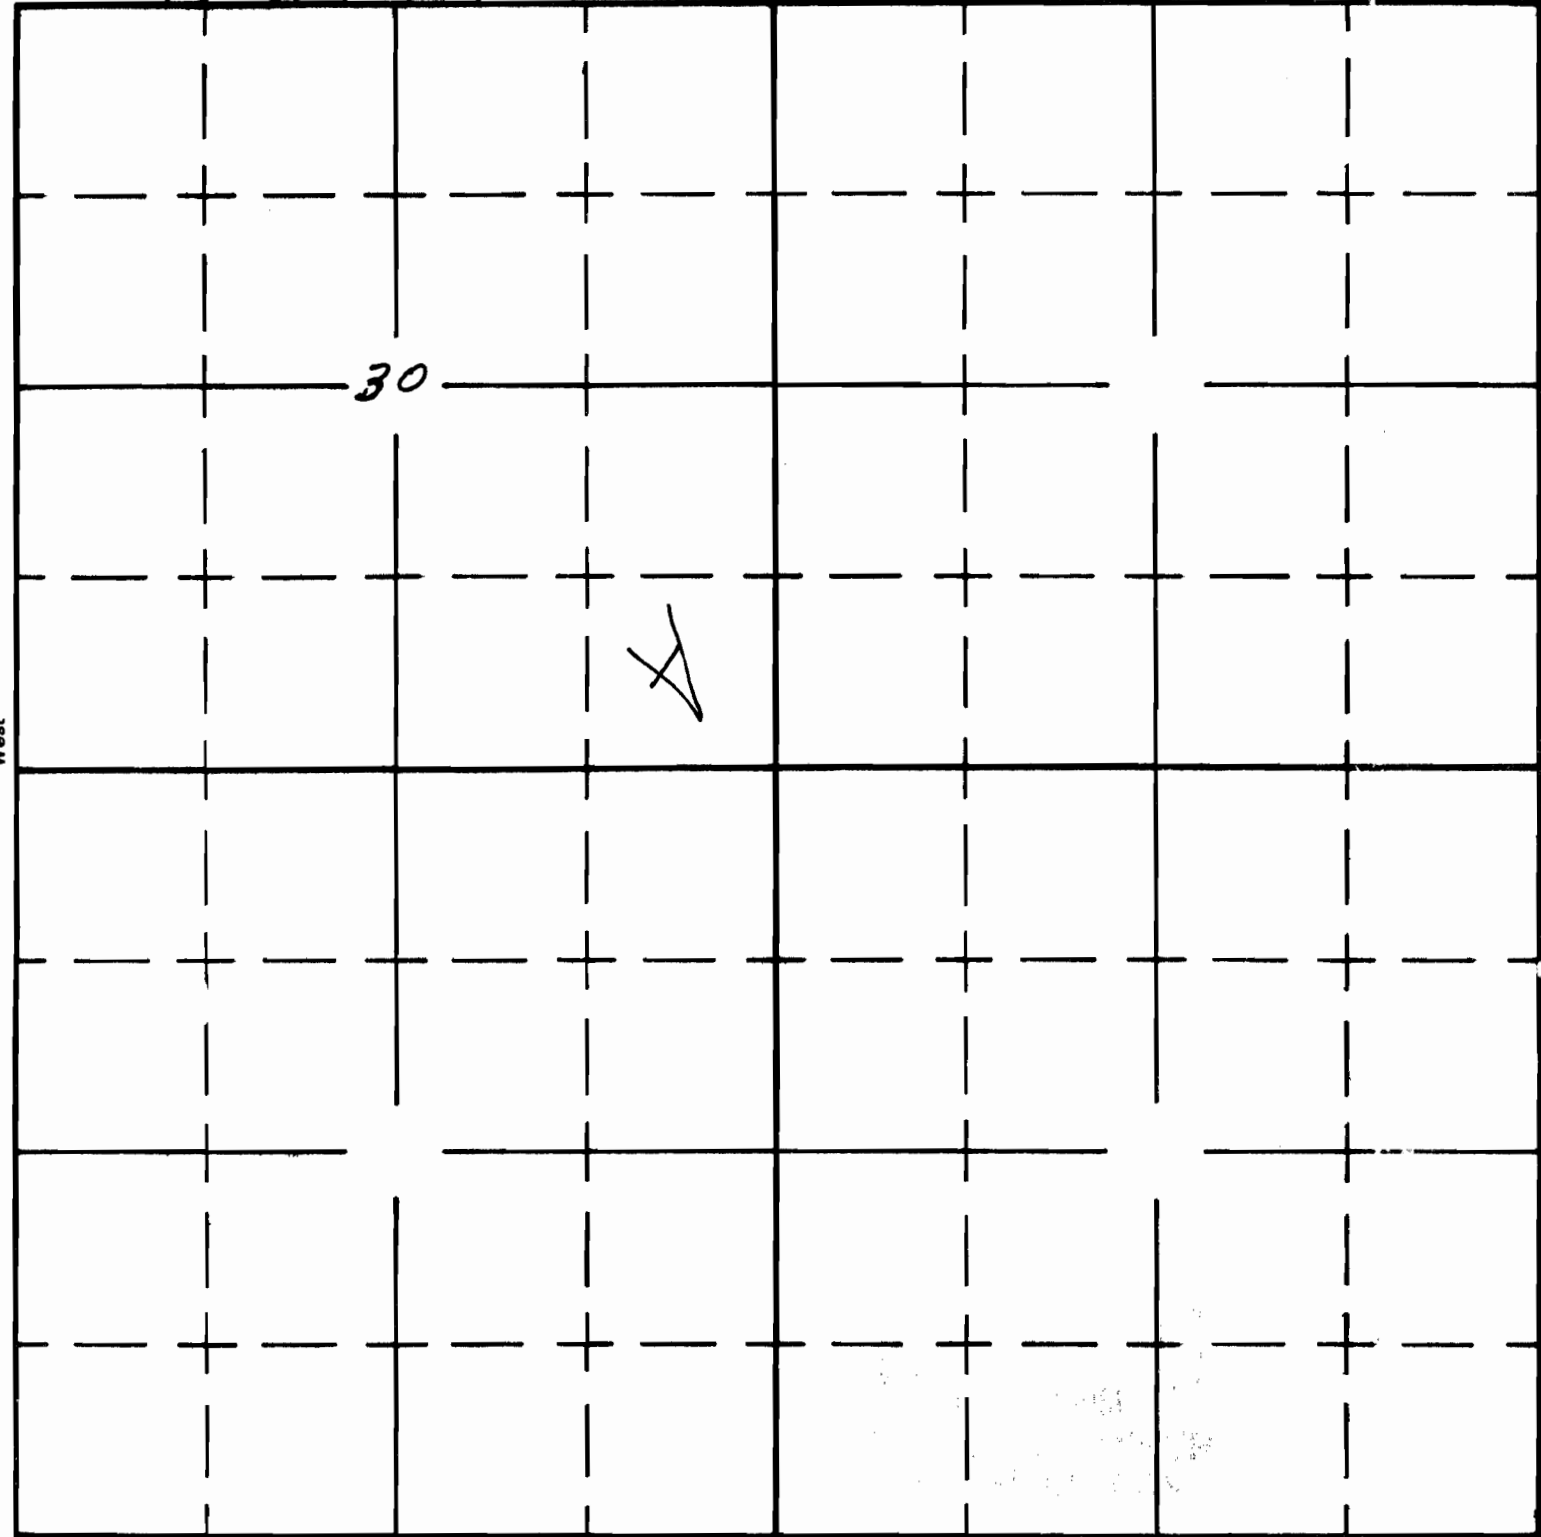

South