

Form AI-187
March 1961

UNITED STATES
DEPARTMENT OF THE INTERIOR
BUREAU OF LAND MANAGEMENT


SECTION

Oregon State Water Filings

23

TOWNSHIP 26S, RANGE 40E, W. M.

North Gallagher Reservoir North

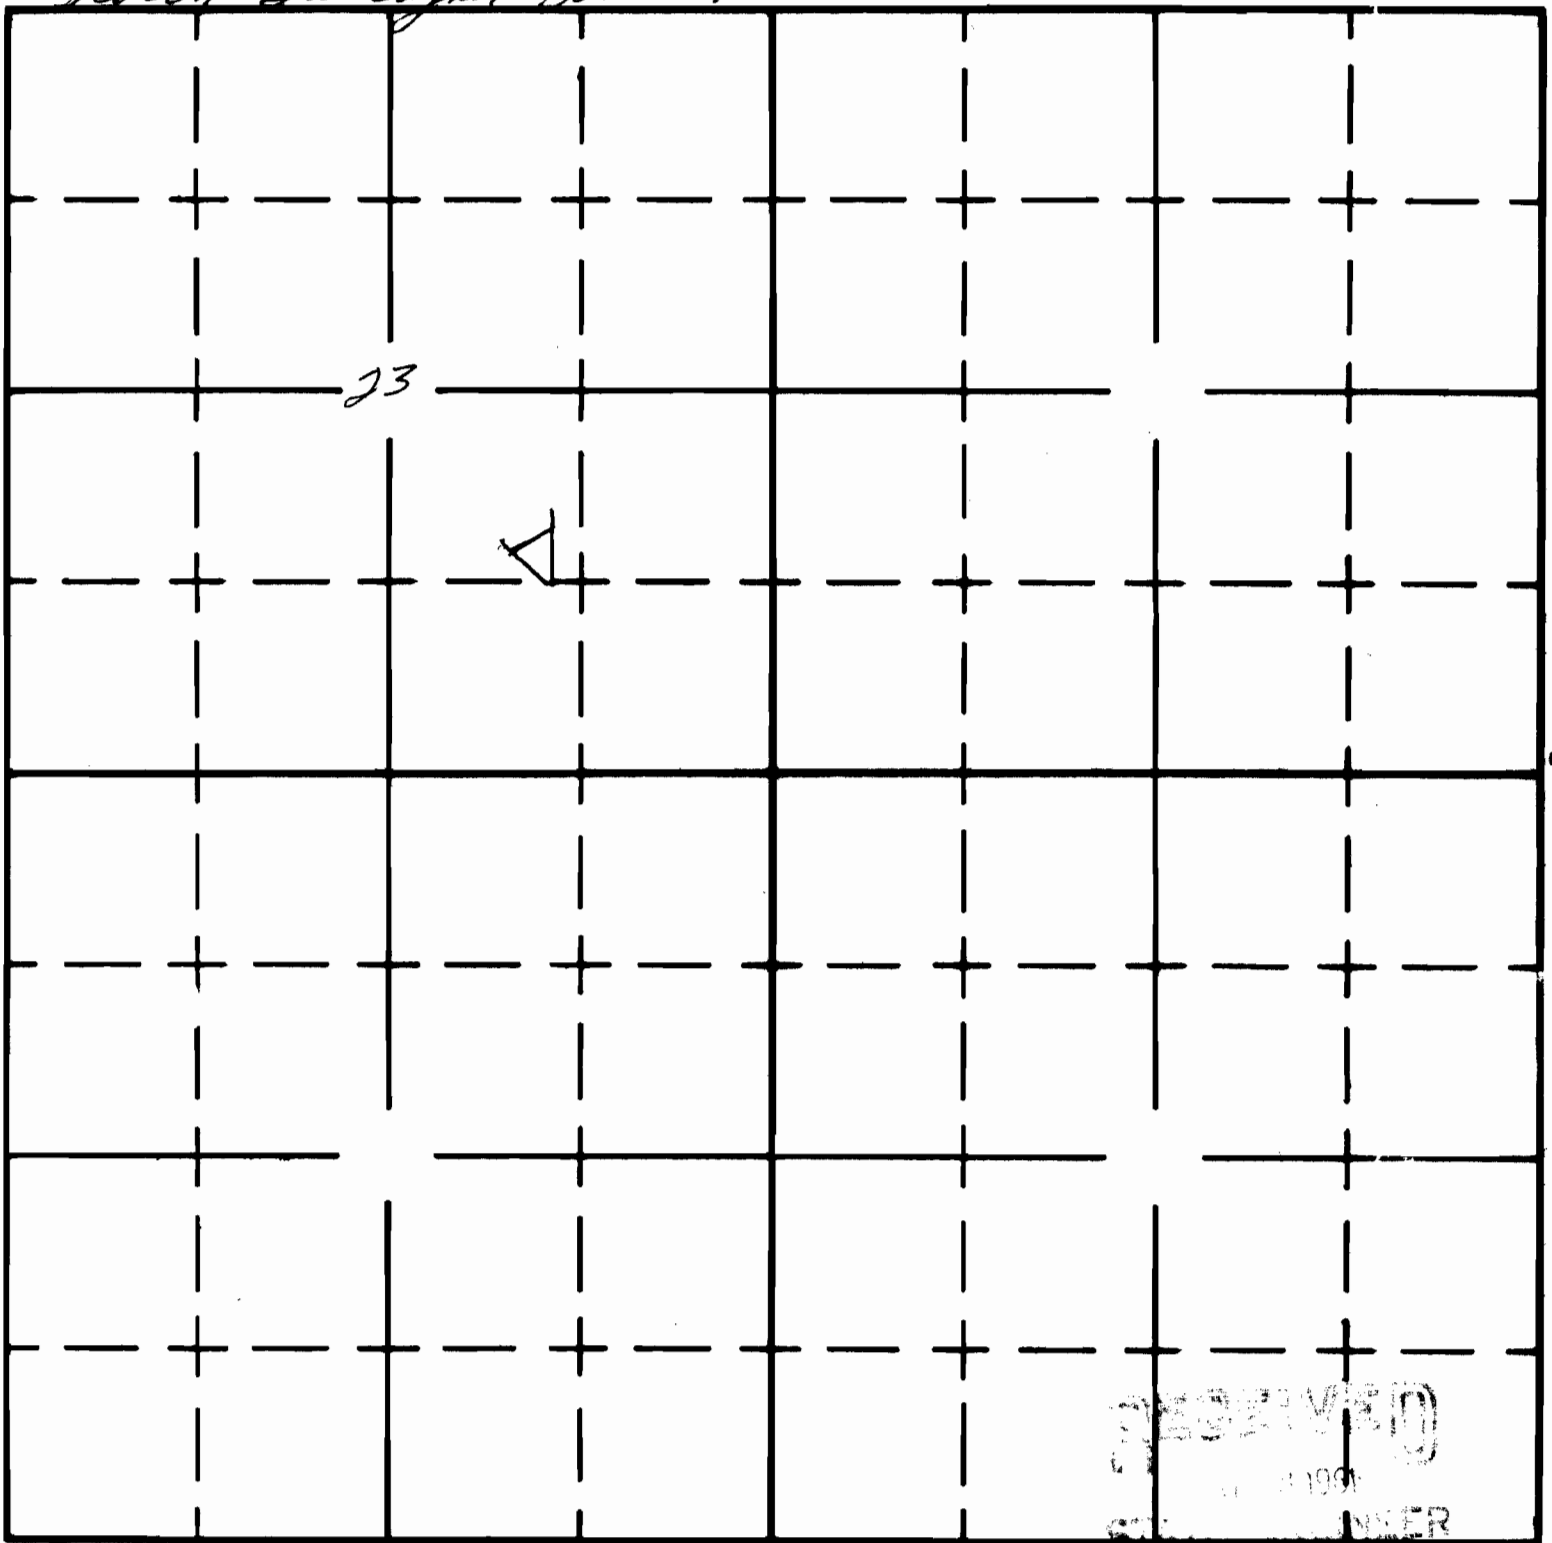

RESERVED
 1991
 SULLIVAN
 SULLIVAN

APPLICATION No. R-36843

PERMIT No. R-4341