

Form AI-187  
March 1961

UNITED STATES  
DEPARTMENT OF THE INTERIOR  
BUREAU OF LAND MANAGEMENT

SECTION


22

# Oregon State Water Filings

TOWNSHIP 25S, RANGE 45E, W. M.

Bar Cross Basin Res.

North

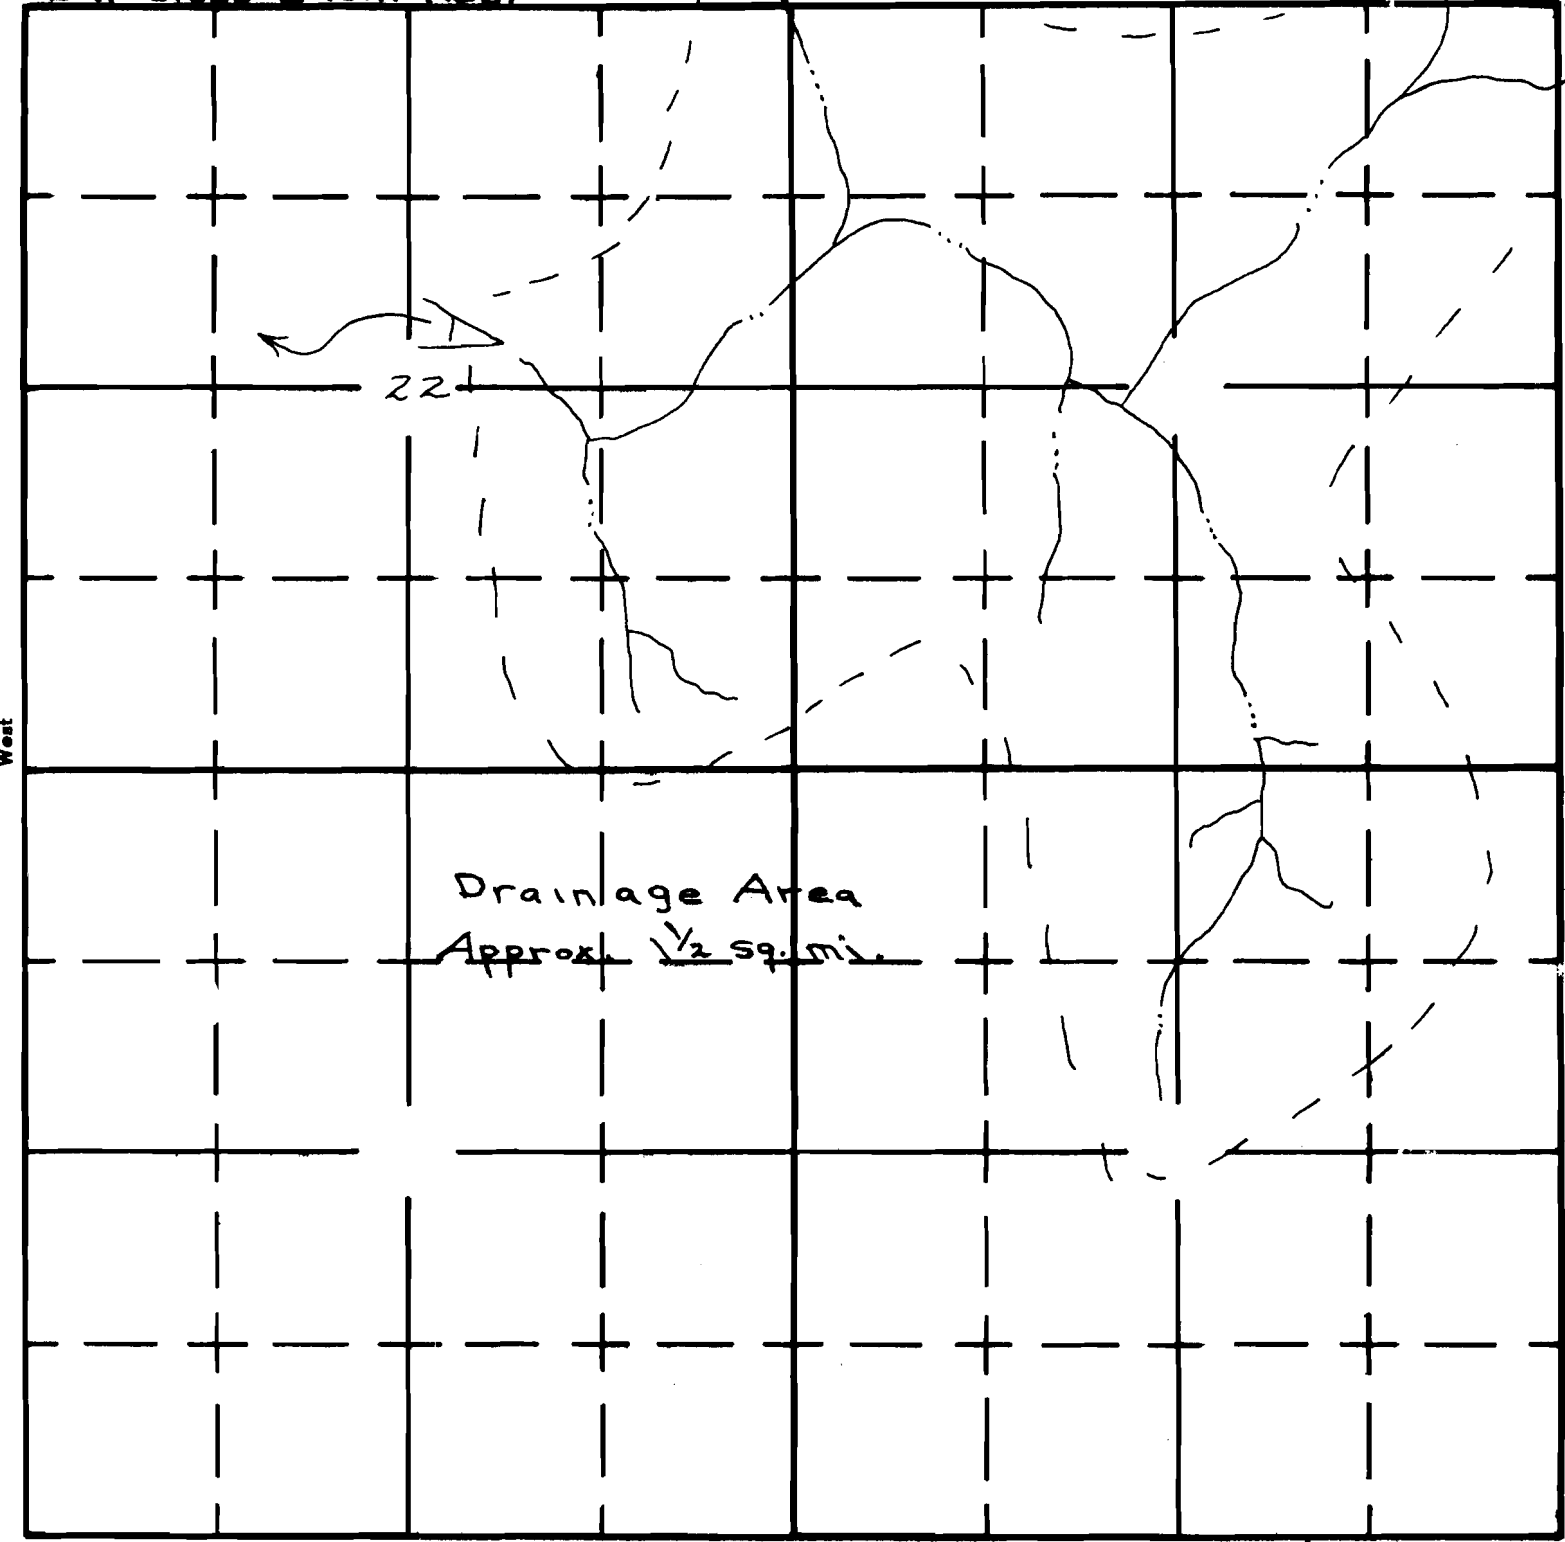

Drainage Area  
Approx.  $\frac{1}{2}$  sq. mi.

West

East

South

APPLICATION No. R-39249  
PERMIT No. R-4382