

Form AI-187
March 1961

UNITED STATES
DEPARTMENT OF THE INTERIOR
BUREAU OF LAND MANAGEMENT

SECTION


29

Oregon State Water Filings

TOWNSHIP 265, RANGE 44E, W. M.

Gin Basin Resv

North

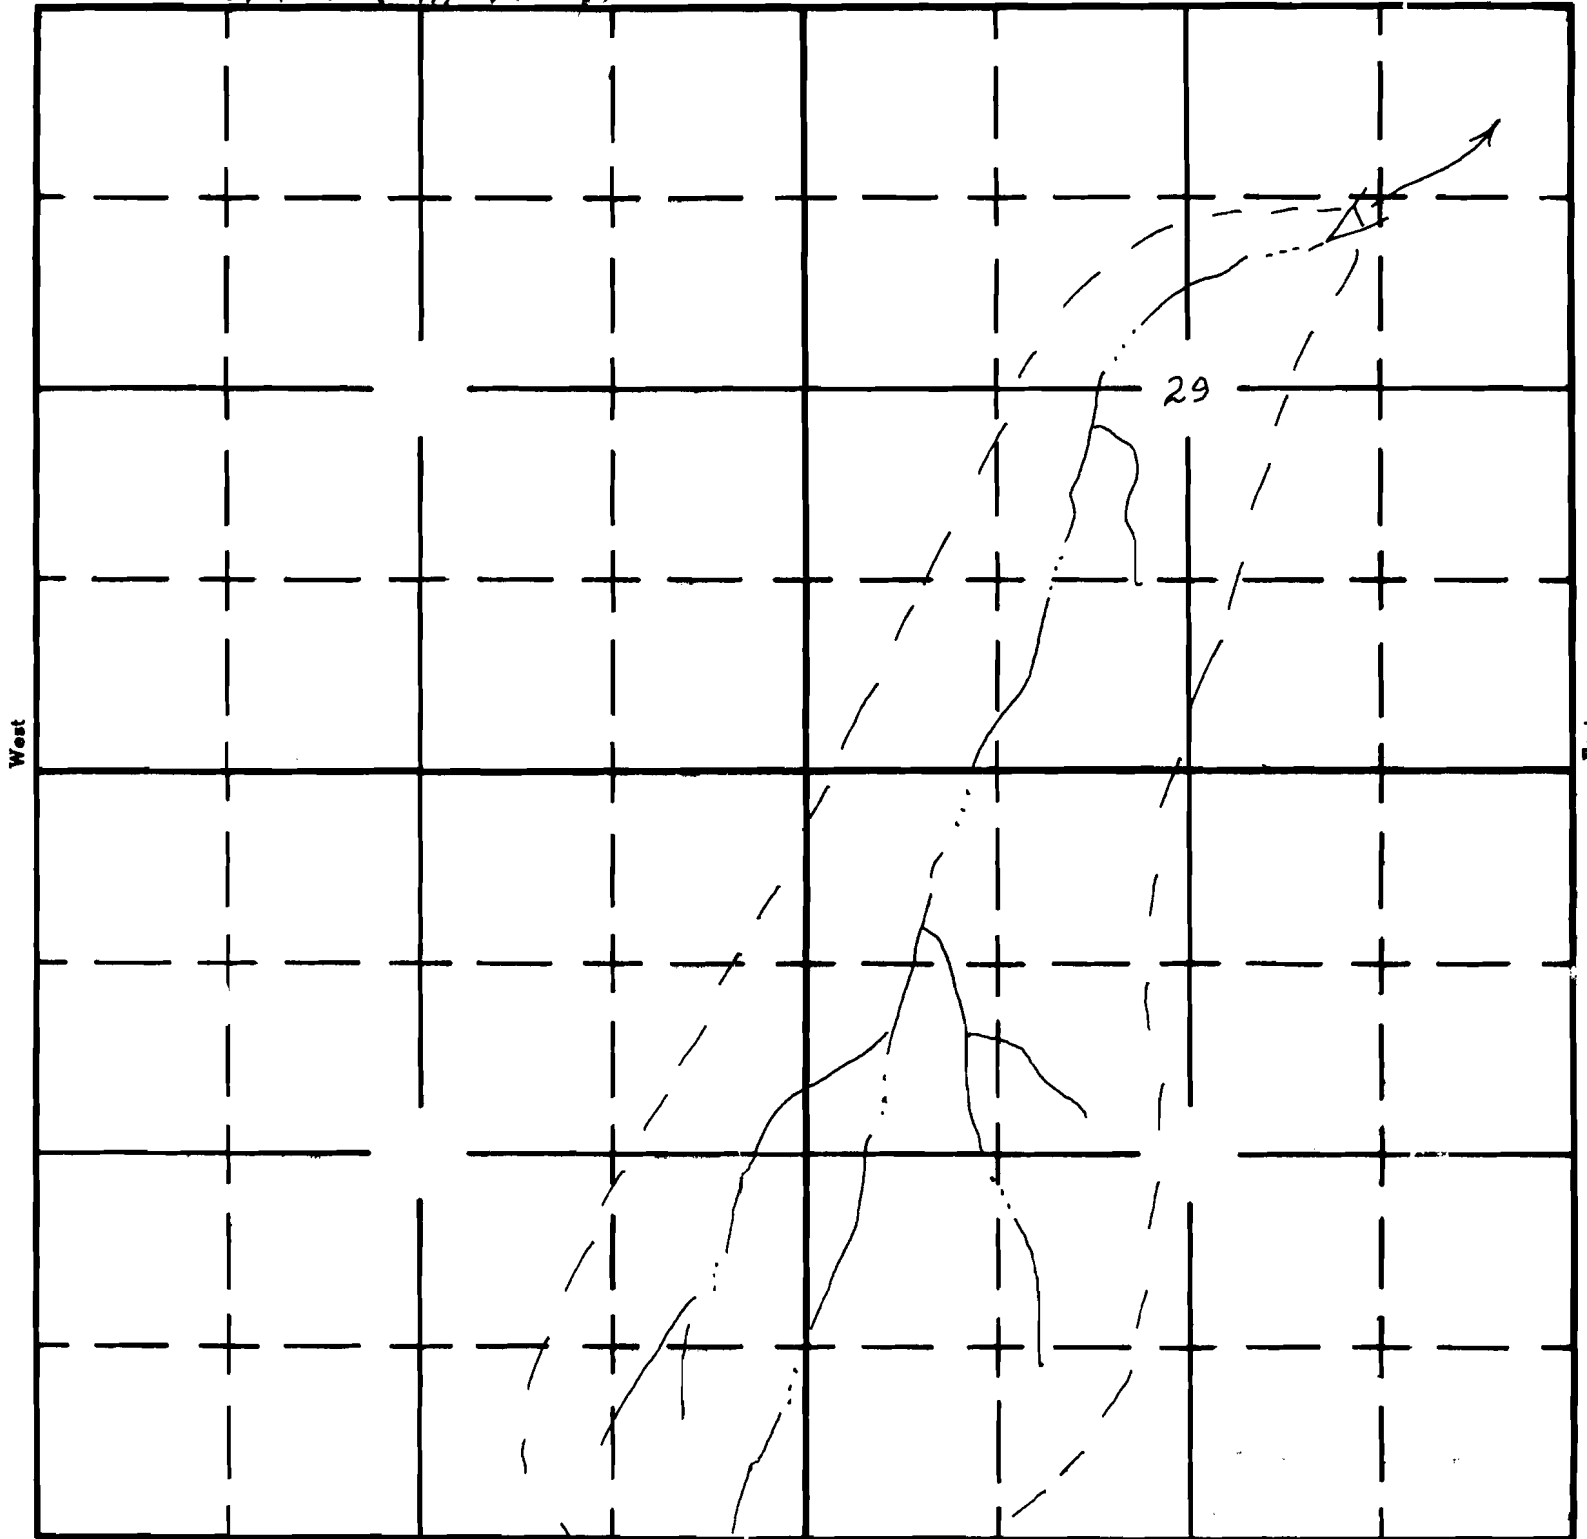

Drainage Area
Approx 159 mi.

South

APPLICATION No. **R-39250**

PERMIT No. **R-4383**