


WATER RIGHT MAP FOR LOCATION CHANGE

SE1/4 SE1/4 SEC 1 T 38S R 48E W.M.

U.S.G.S. QUAD - BEAVER CHARLIE BREAKS, OREG. - 7 1/2'

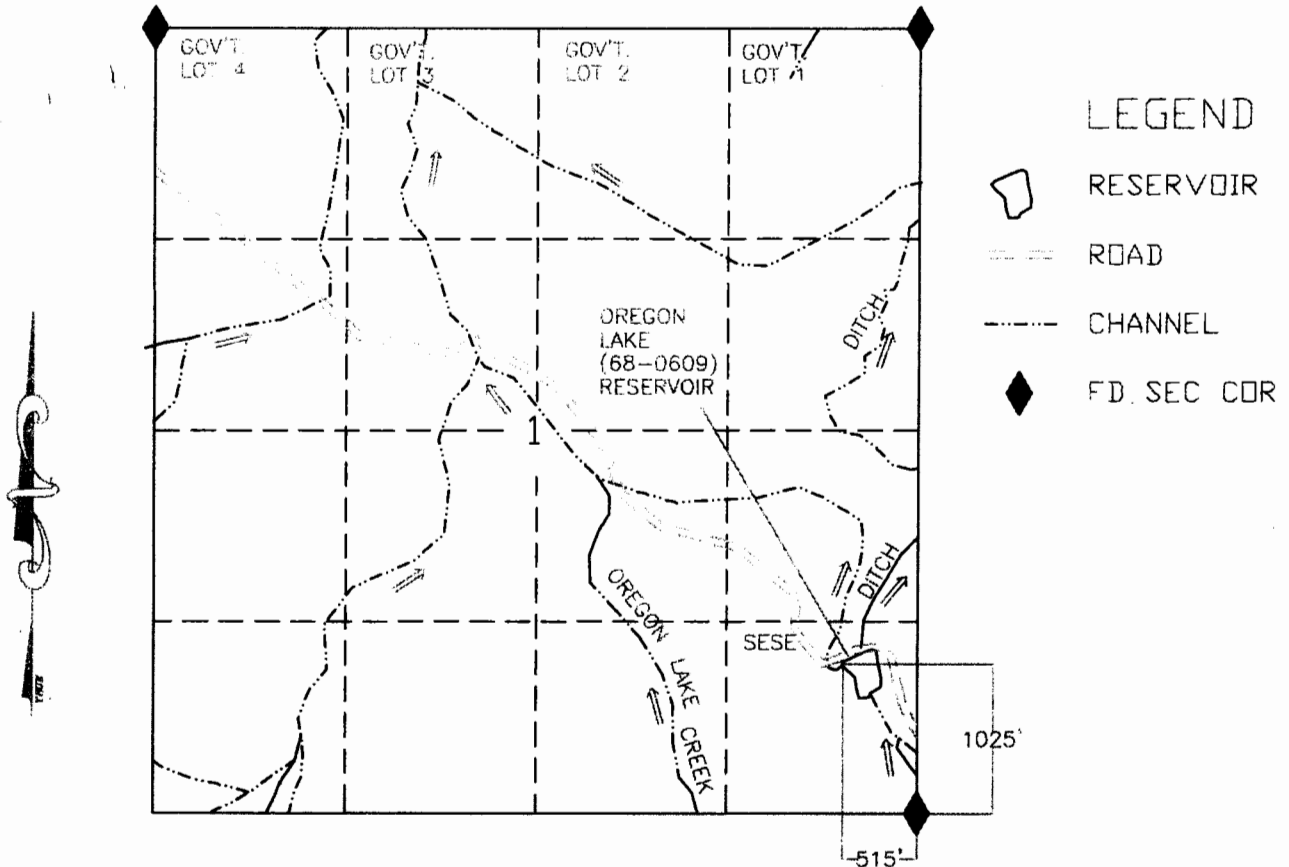


OREGON LAKE (68-0609) RESERVOIR

RECEIVED

JAN 09 2004

WATER RESOURCES DEPT
SALEM, OREGON

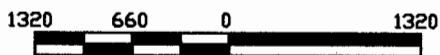

SCALE 1"=1320'

THIS MAP IS FOR THE PURPOSE OF LOCATING
A WATER RIGHT AND IS NOT INTENDED TO
PROVIDE LEGAL DIMENSIONS FOR LOCATION
OF PROPERTY BOUNDARIES.



ACAD 13/SDSK
DWG FILE: OREGON.LK.DWG

UNITED STATES DEPARTMENT OF THE INTERIOR
BUREAU OF LAND MANAGEMENT
DIVISION OF OPERATIONS VALE DISTRICT

OREGON LAKE
(68-0609) RESERVOIR

DESIGNED		
REVIEWED		
APPROVED	<i>Thomas D. Perry</i> CHIEF, BRANCH OF ENGINEERING	
DRAWN	CG	SCALE: 1"=1320'
DATE	12/19/94	SHEET 1 OF 1
DRAWING NO.	OR-03-9172.45-720	