


T.39 S., R.7 W., W.M.

SEC. 24

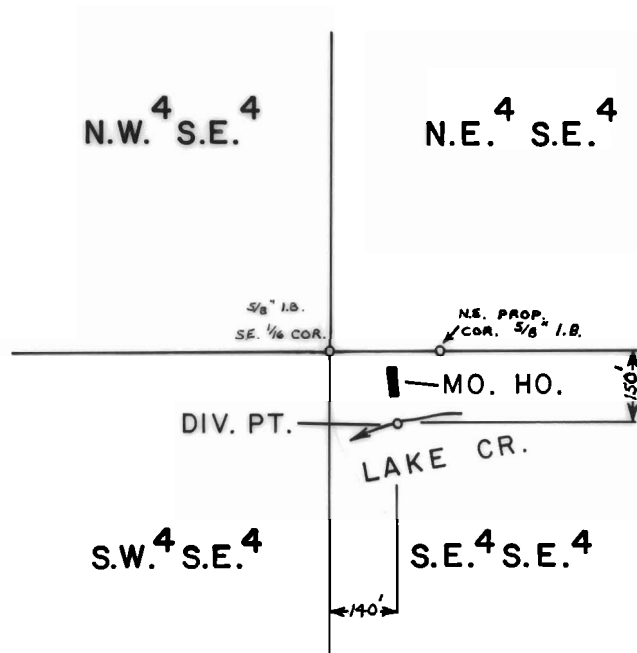

SCALE: 1" = 400 FT.

FINAL PROOF SURVEY
UNDER

Application No. 58281 Permit No. 43894
IN NAME OF

ERNEST ST. JAMES BIERI & LOUELLA PEARL BIERI

Surveyed JUN. 12 1979 by B. SUND

D.H.M.

P.T.S. - 1979 - 14 - B