

UNITED STATES
DEPARTMENT OF THE INTERIOR
BUREAU OF LAND MANAGEMENT

SECTION

19


Oregon State Water Filings

NE $\frac{1}{4}$ NW $\frac{1}{4}$

TOWNSHIP 20 S, RANGE 38 E, W. M.

ADOBE RESERVOIR

North

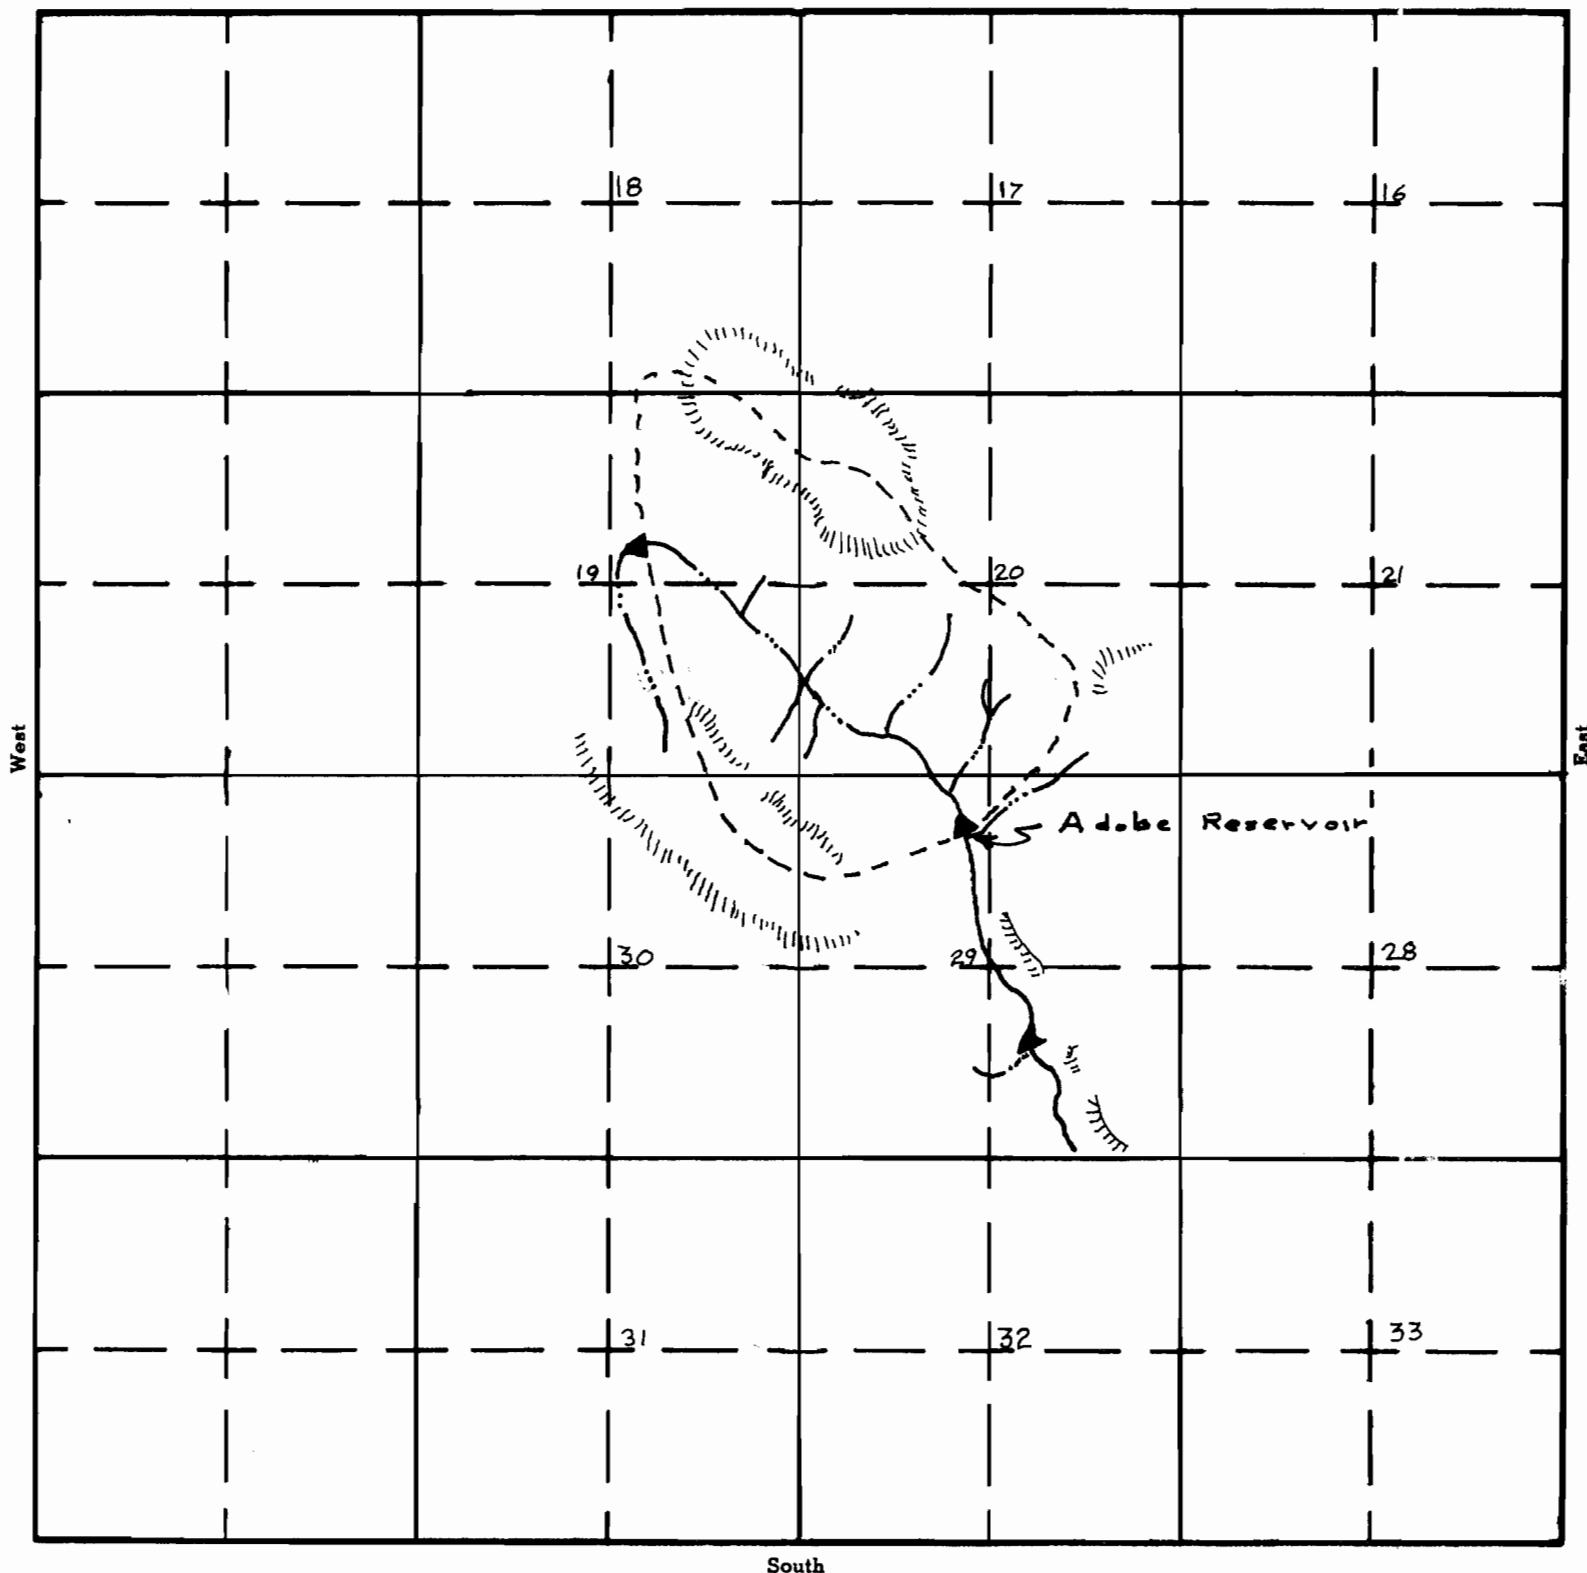

APPLICATION No. R-4104-14

PERMIT No. R-5170