

UNITED STATES
DEPARTMENT OF THE INTERIOR
BUREAU OF LAND MANAGEMENT


SECTION

Oregon State Water Filings

21
SW⁴ NE⁴

TOWNSHIP 31 S., RANGE 43 E., W. M.

North AROCK #3 RESERVOIR

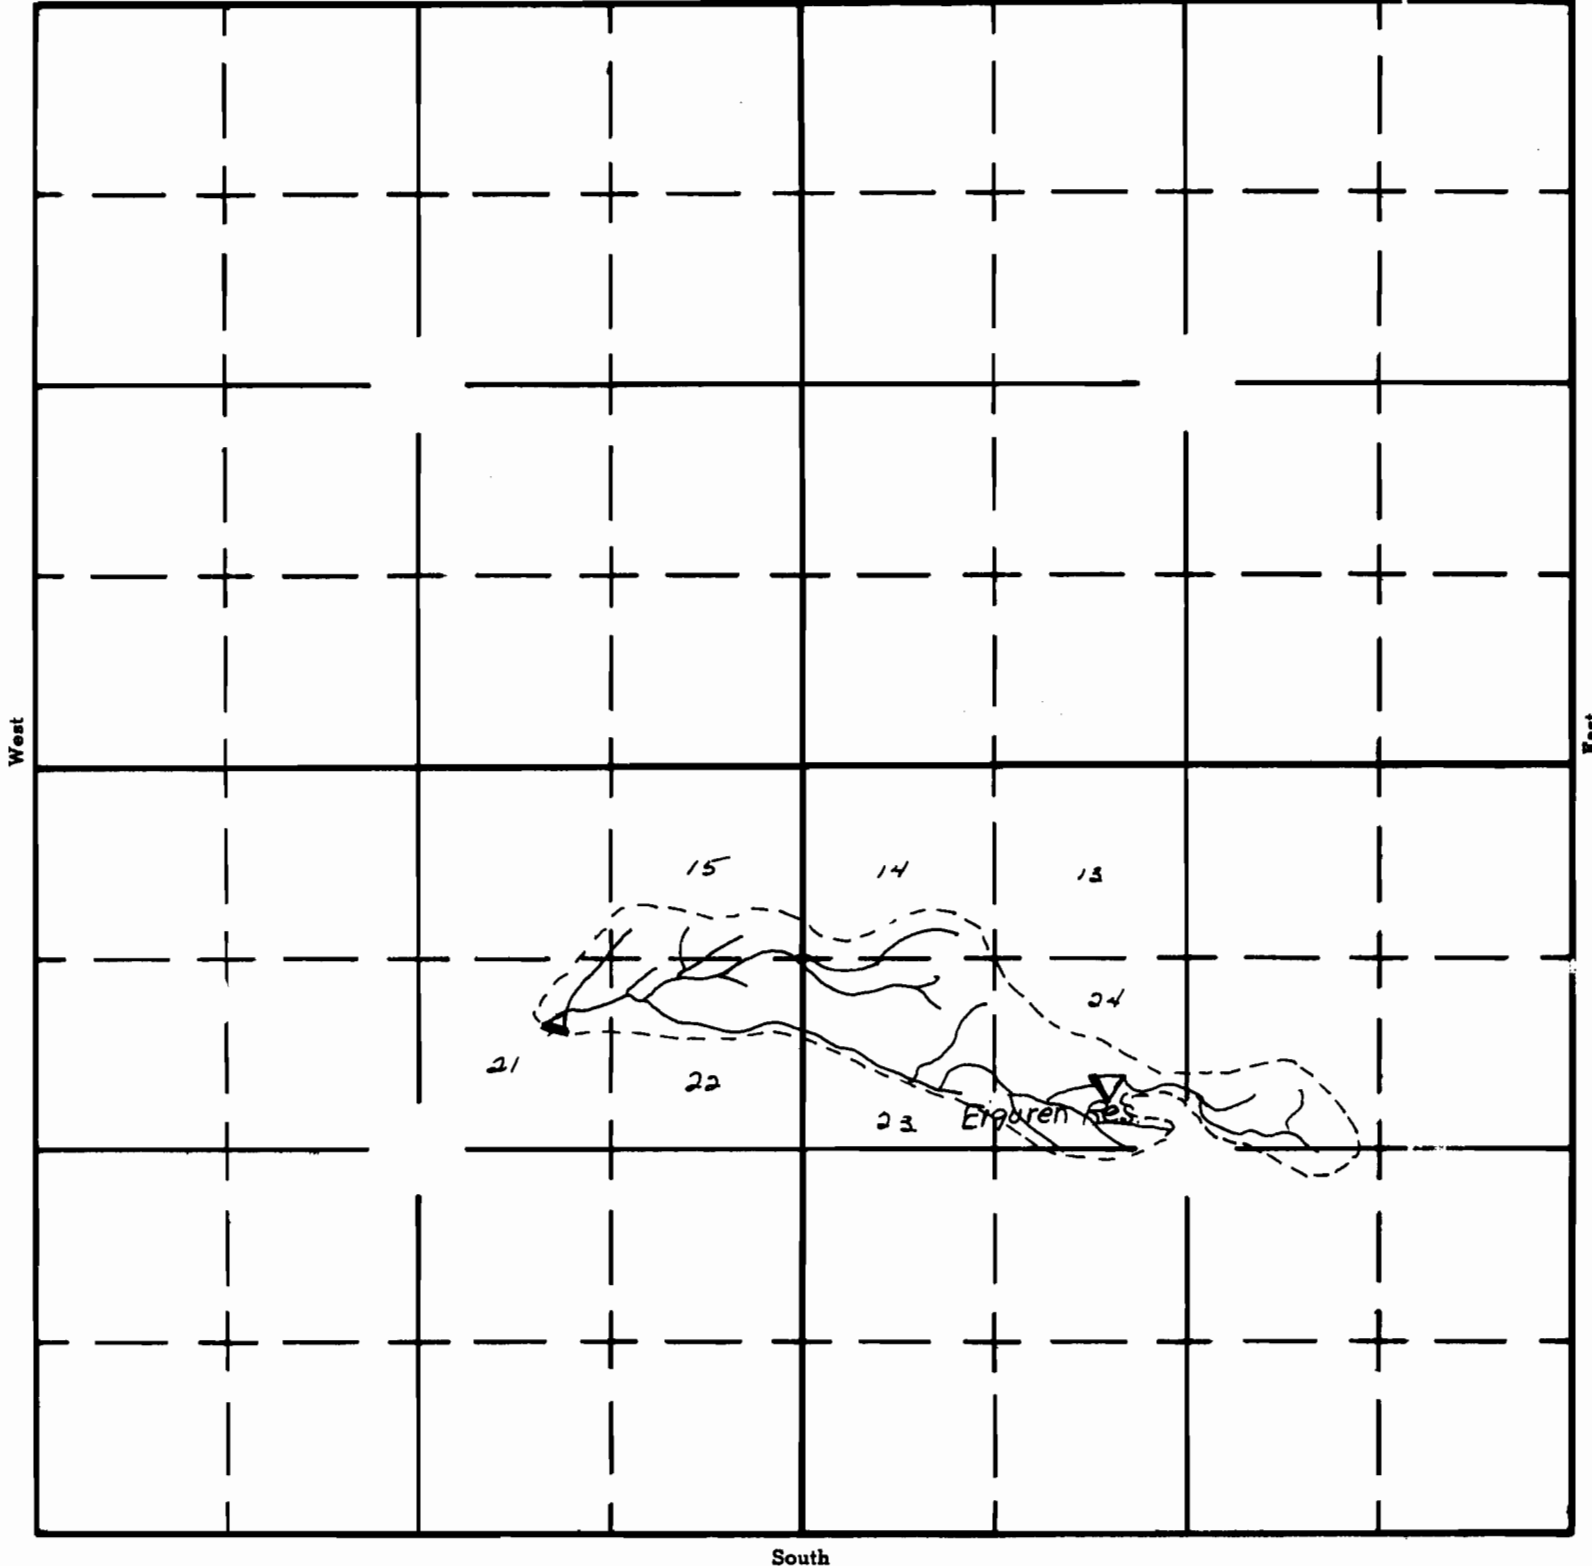

APPLICATION No. R-41495

PERMIT No. R-5203