

Form AI-187
March 1961


UNITED STATES
DEPARTMENT OF THE INTERIOR
BUREAU OF LAND MANAGEMENT

SECTION

33
34
3
4

Oregon State Water Filings

TOWNSHIP ^{22^s}23^r, RANGE ^{42^E}42^E, W.M.

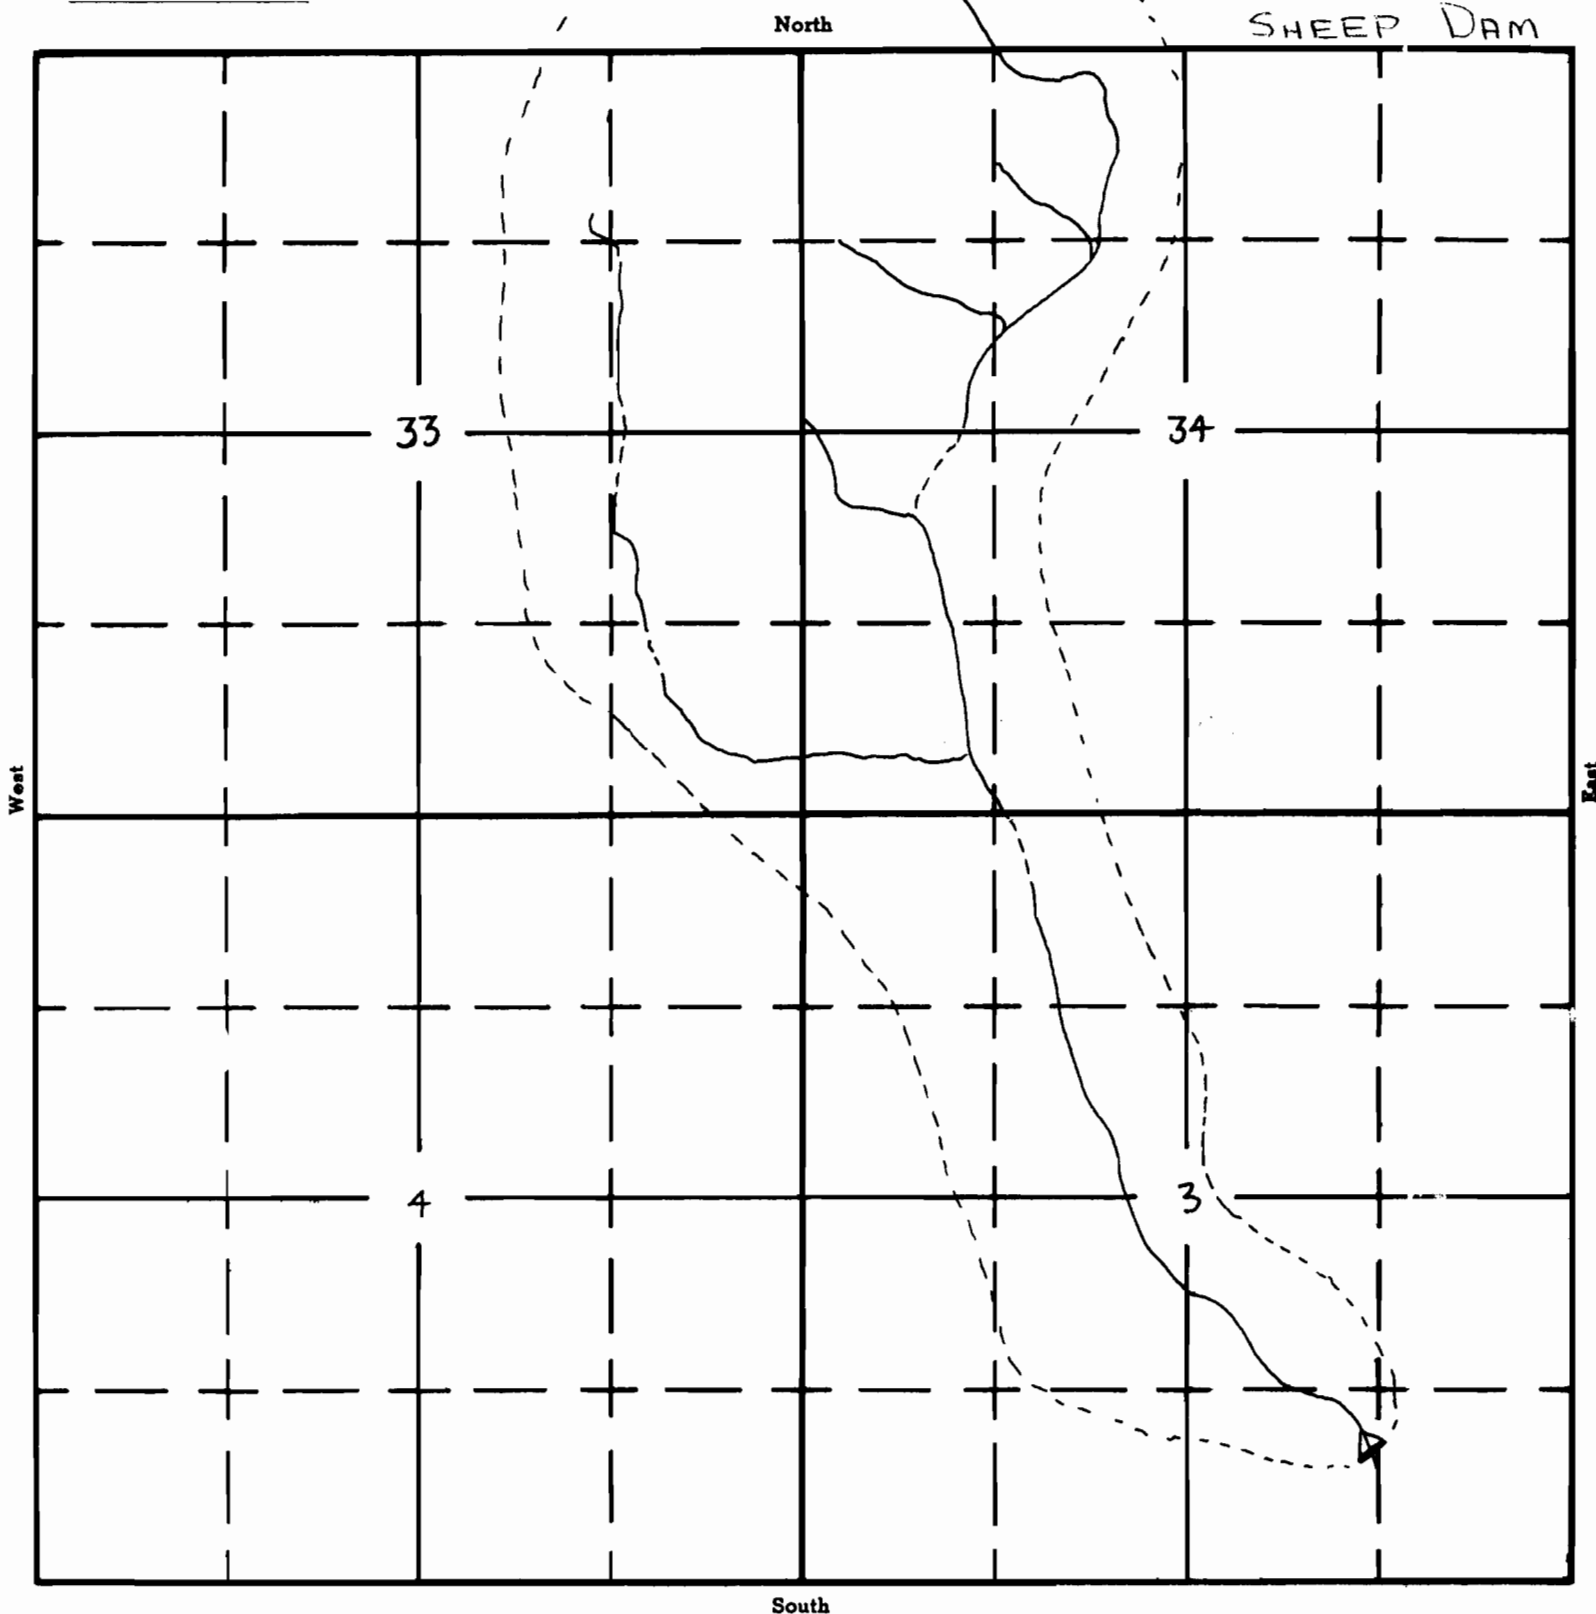

South

APPLICATION No. R-41502

PERMIT No. R-5210