

UNITED STATES
DEPARTMENT OF THE INTERIOR
BUREAU OF LAND MANAGEMENT

SECTION

21


Oregon State Water Filings

NE⁴ NW⁴

TOWNSHIP 16S, RANGE 45E, W. M.

ALKALI RES.

North

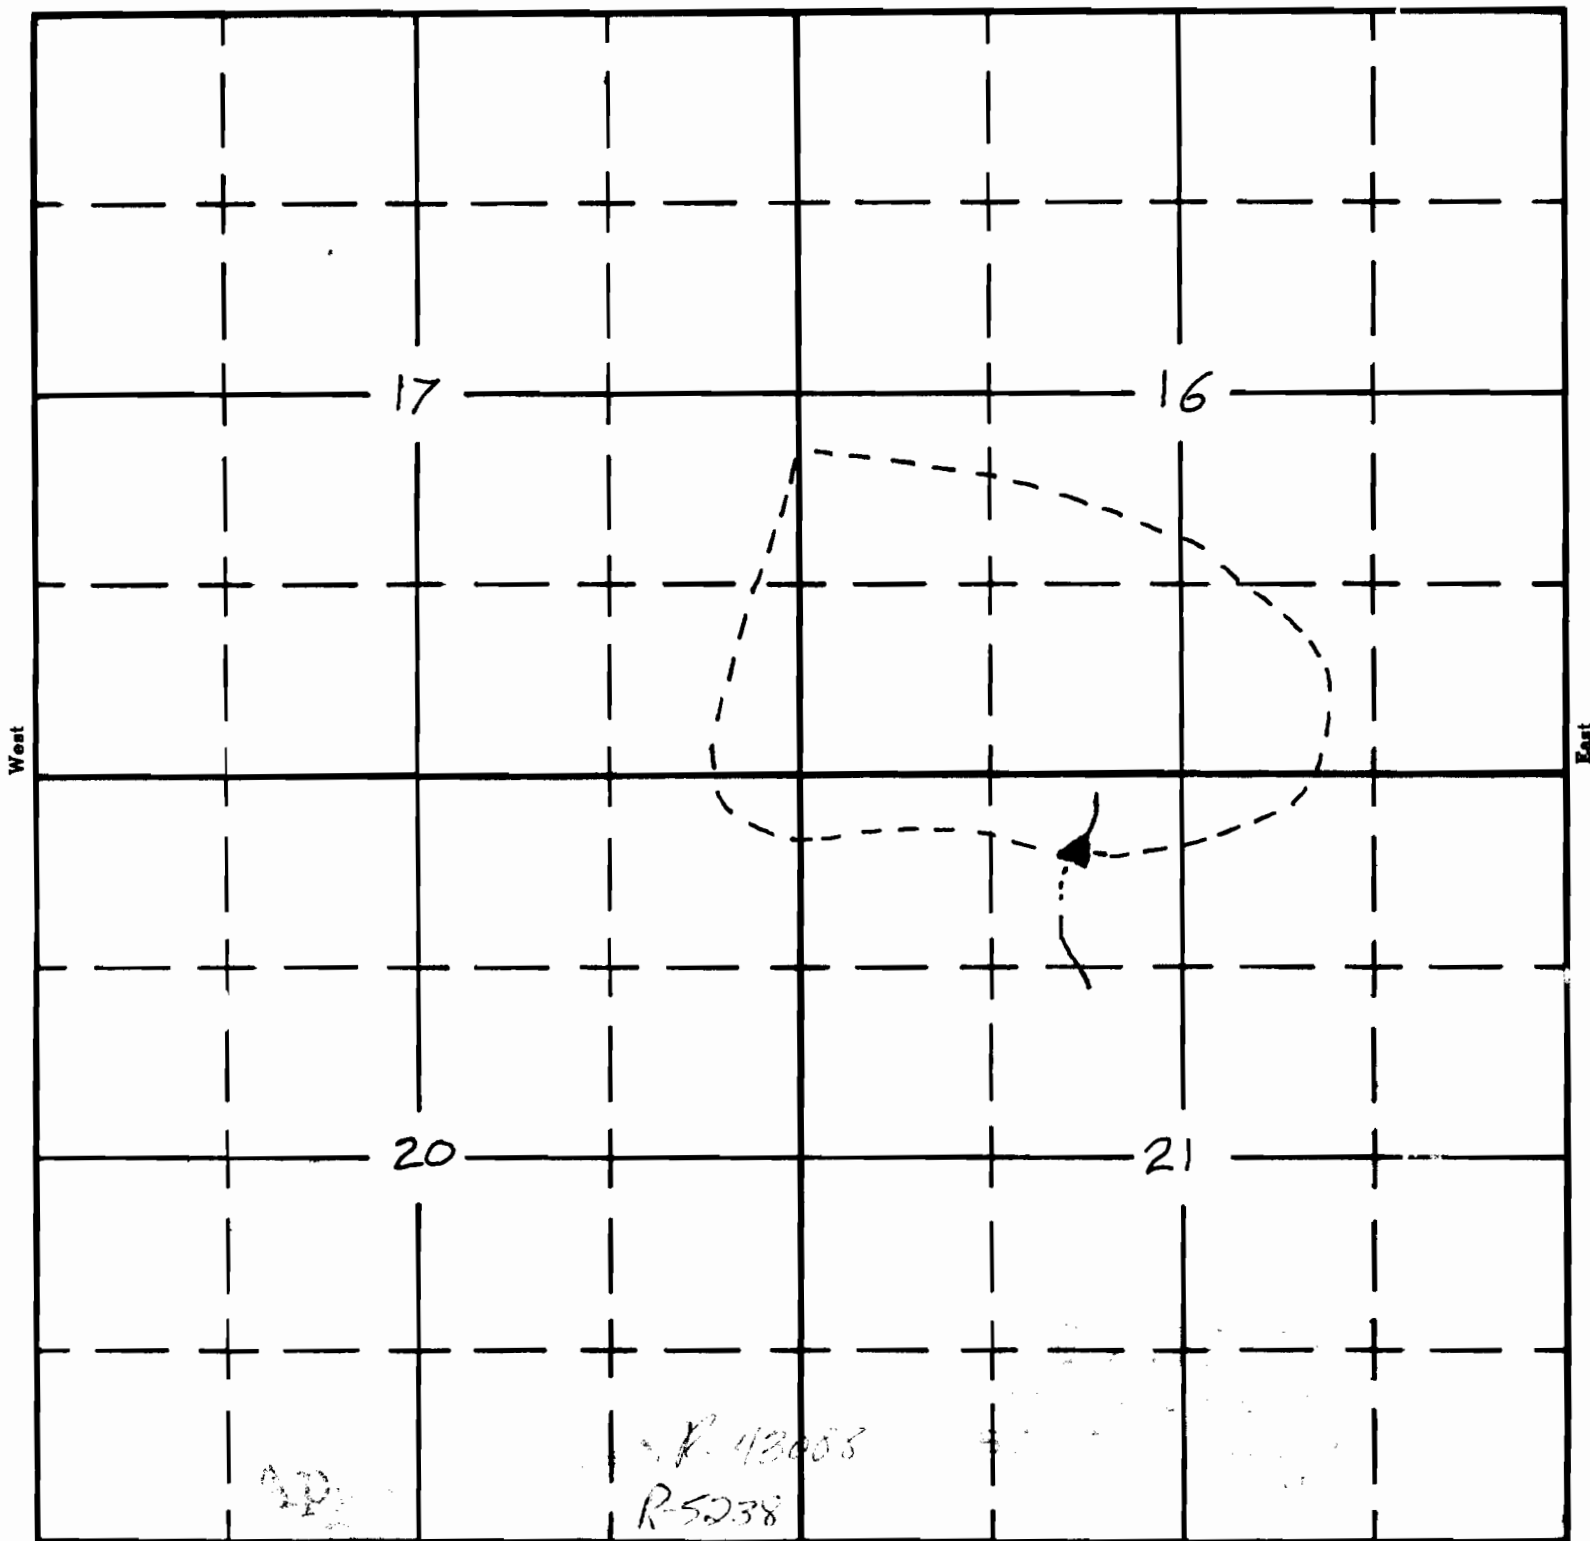

South

APPLICATION No.
PERMIT No.