

Form AP-187
March 1961

UNITED STATES
DEPARTMENT OF THE INTERIOR
BUREAU OF LAND MANAGEMENT


SECTION

Oregon State Water Filings

NW⁴ NE⁴
Sec. 15

TOWNSHIP 20 S., RANGE 41 E., W. M.

BROWN RESERVOIR
North

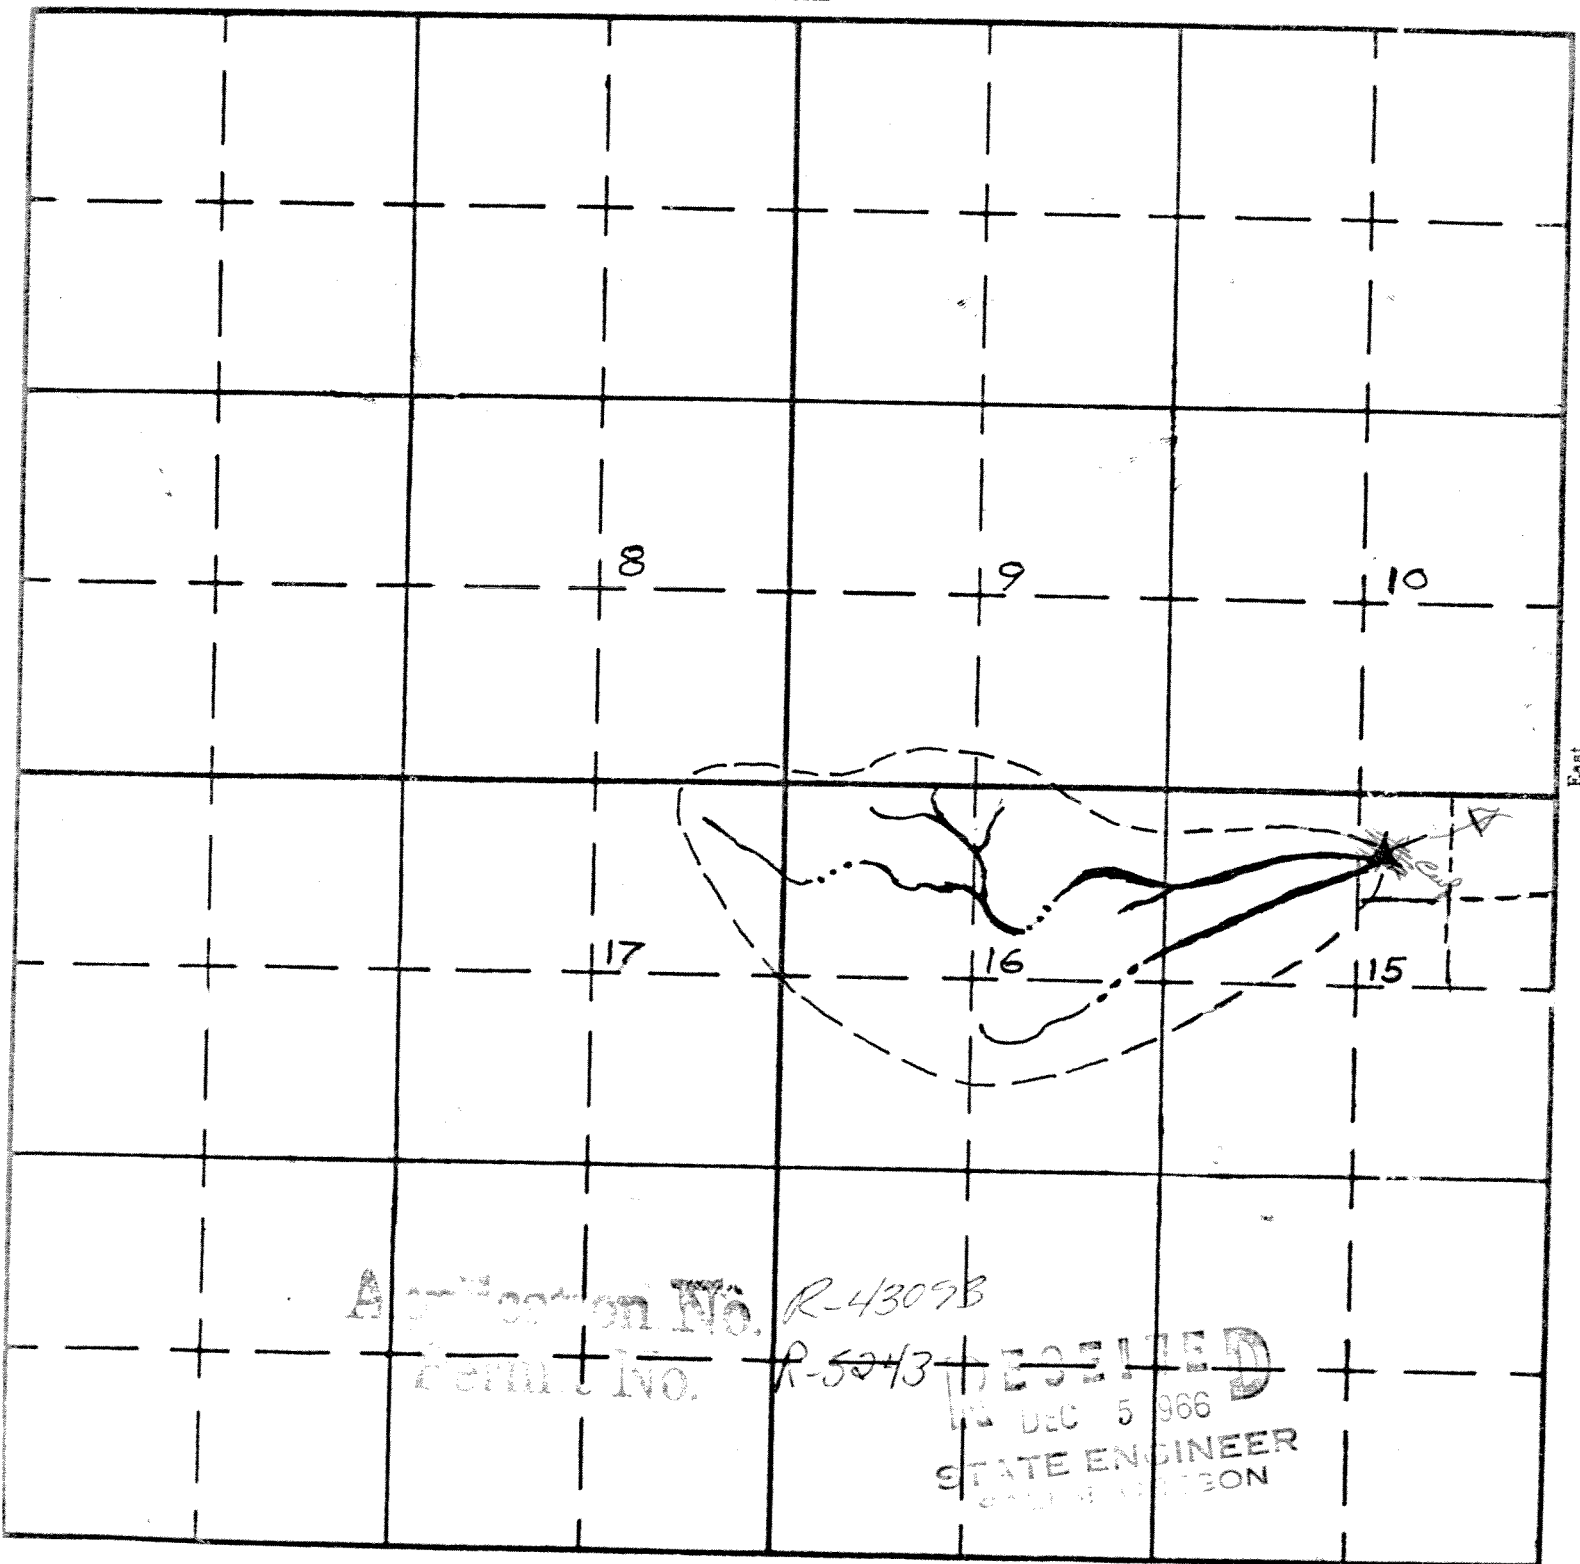

Application No. R-4309B

Permit No. R-5243

RECEIVED
DEC 5 1966
STATE ENGINEER

APPLICATION No.