


T.9S., R.1W., W.M.

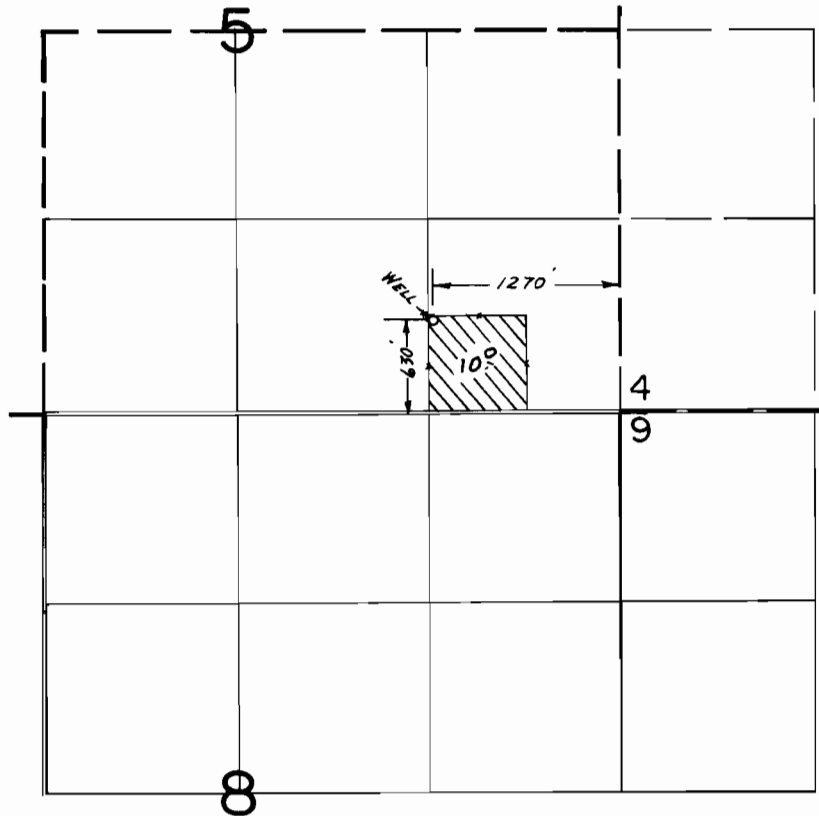

FINAL PROOF SURVEY
UNDER

Application No. G-8278. Permit No. G-7530....
IN NAME OF

.....LEO J. & MARY ANN BRINKMANN

Surveyed JULY 28, 1981, by L.M. TOLL.....