


T. 15., R. 3W., W.M.

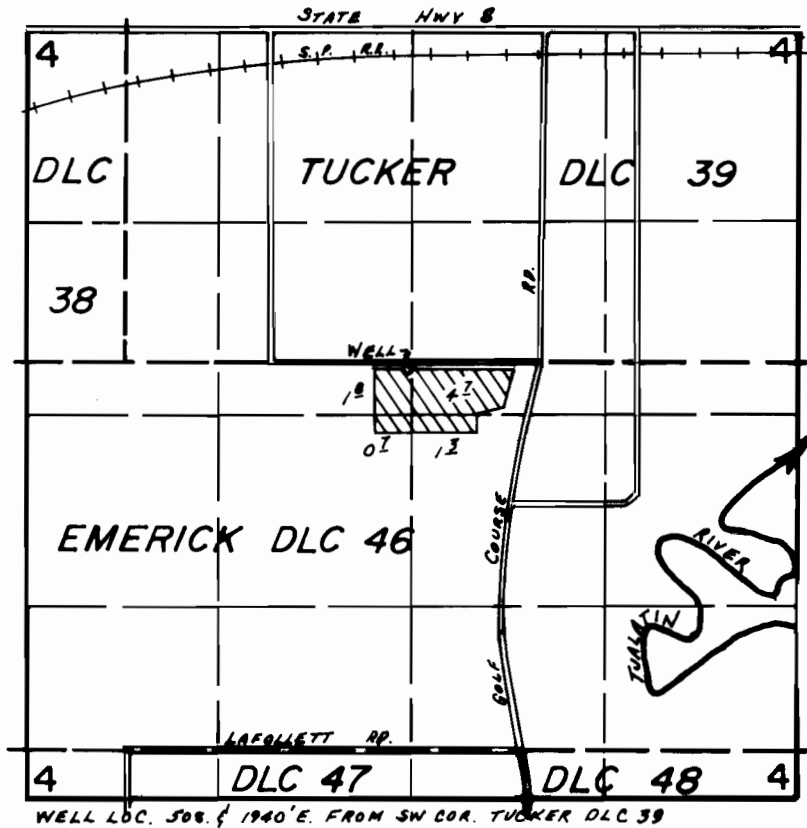

FINAL PROOF SURVEY UNDER

Application No. G-5723 Permit No. G-5524
IN NAME OF

CITY OF CORNELIUS

Surveyed JULY 17, 1980, by R.G. MUCKEN