


T.2N. R.13E. W.M.

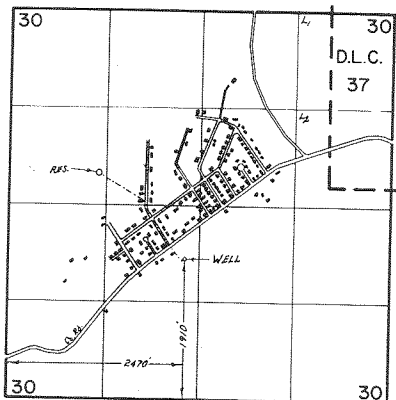

FINAL PROOF SURVEY
UNDER

Application No. G-7447 Permit No. G-6941
IN NAME OF

LOWER CHENOWITH WATER DISTRICT

Surveyed Oct. 20, 1983, by T. J. Paul.....