


G6995
58328

T. 6 N. R. 34 E. W.M.

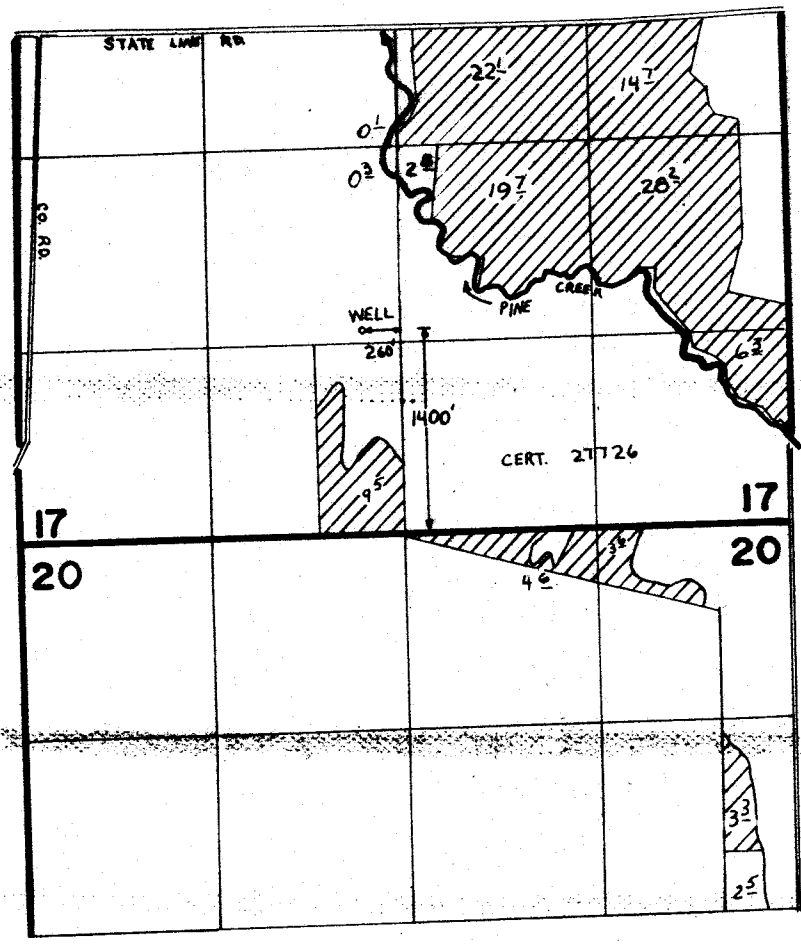

N
Scale 1" = 1320'

FINAL PROOF SURVEY UNDER

Application No. G.7521... Permit No. G.6995.....
IN NAME OF

.....STATE LINE RANCH, INC.....

Surveyed April...10.. 1984, by V.Church.....