


G-7353
58329

T.38 S., R.20 E., W.M.

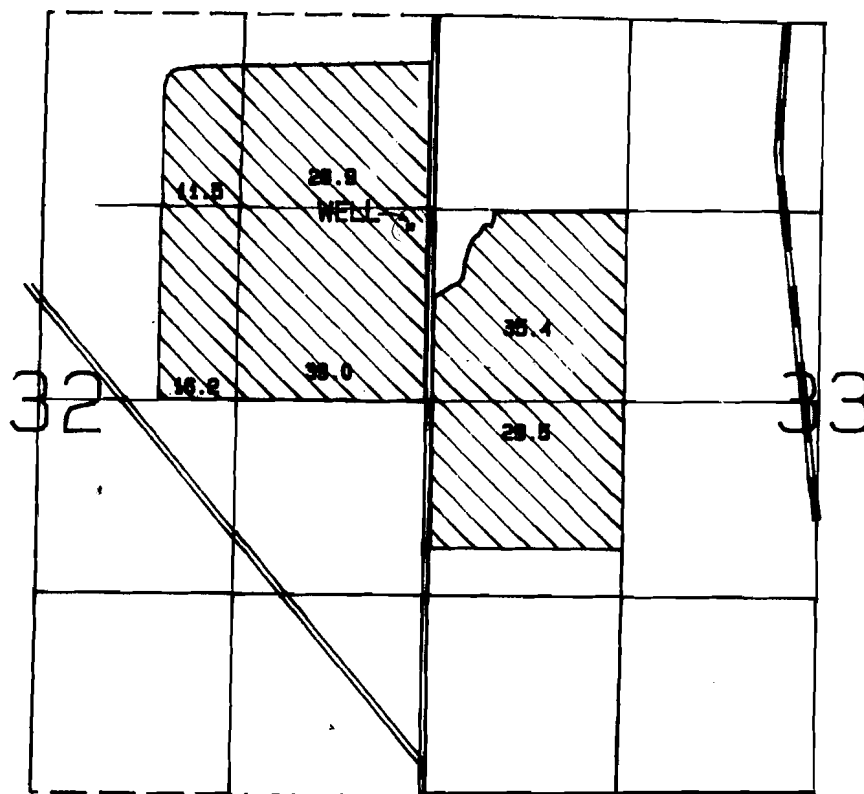

SCALE: 1" = 1320'

WELL LOCATED 1430 FT. S. AND 140 FT. W. FROM NE. COR. SEC. 32

FINAL PROOF SURVEY
UNDER

APPLICATION NO. 6-8289 PERMIT NO. 6-7353

IN NAME OF
DONALD T. JONES

Surveyed Oct. 19, 1987 By B.S. JAMES

Photo: 379-720C DLM